



1-800-227-2600
AVOID CUTTING
UNDERGROUND UTILITIES

OWNER/DEVELOPER:

CITY OF ELKO
ATTN: MR. DALE JOHNSON
1550 STP ROAD.
ELKO, NV 89801
PH.: (775) 777-7210
FAX: (775) 774-7388


ENGINEER




1751 COLLEGE AVE.
ELKO, NV 89801
PH.: (775) 777-7210
FAX: (775) 774-7219

CITY OF ELKO

EXIT 298 SEWER AND WATER DESIGN
PHASE 2 SEWER CONSTRUCTION

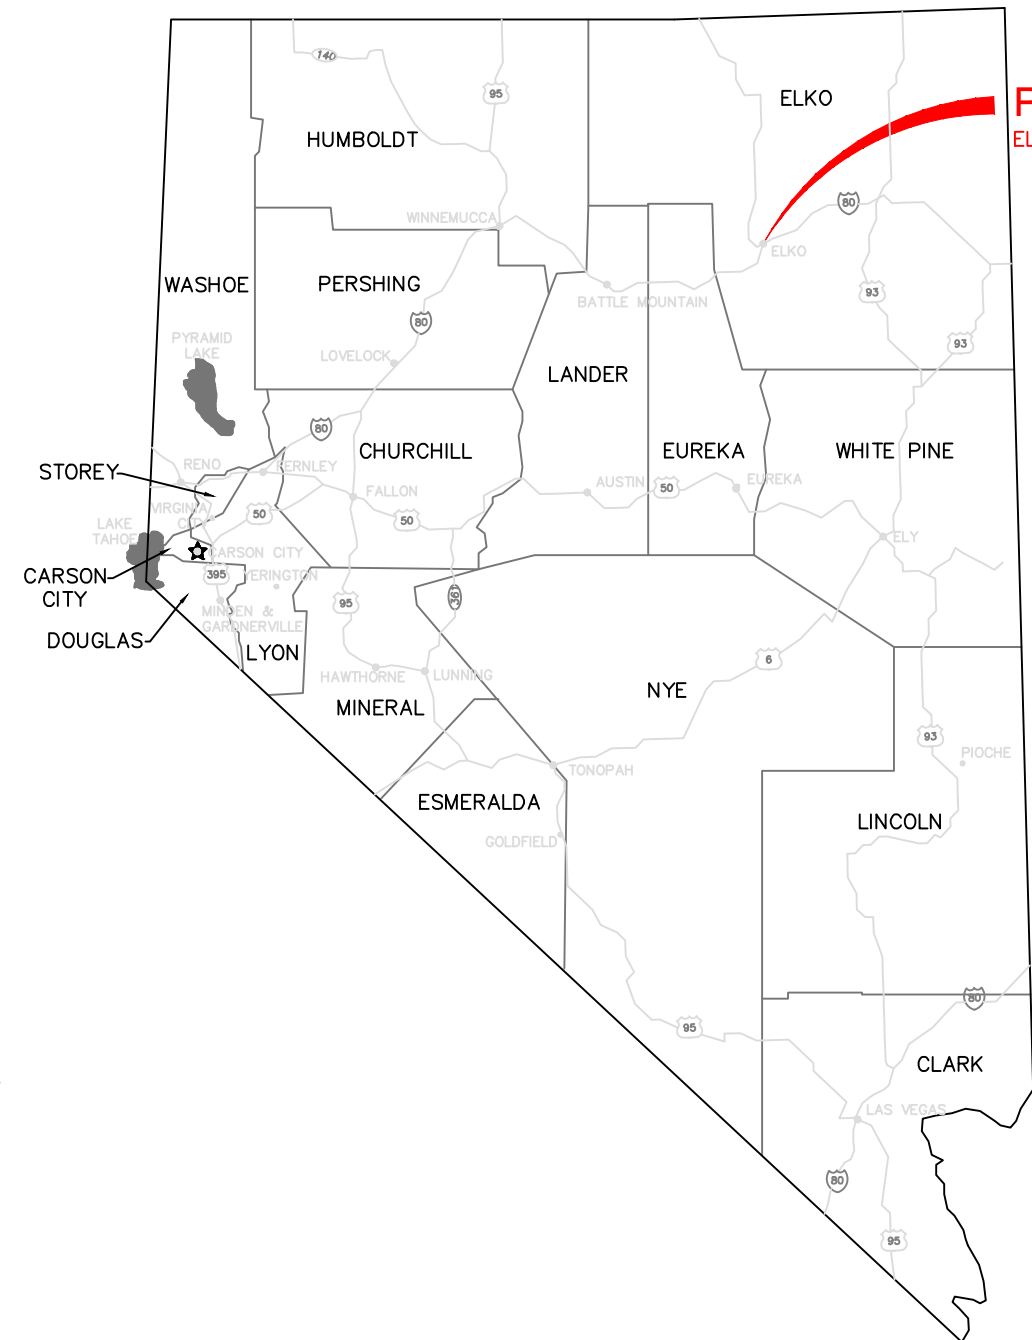

LOCATION MAP

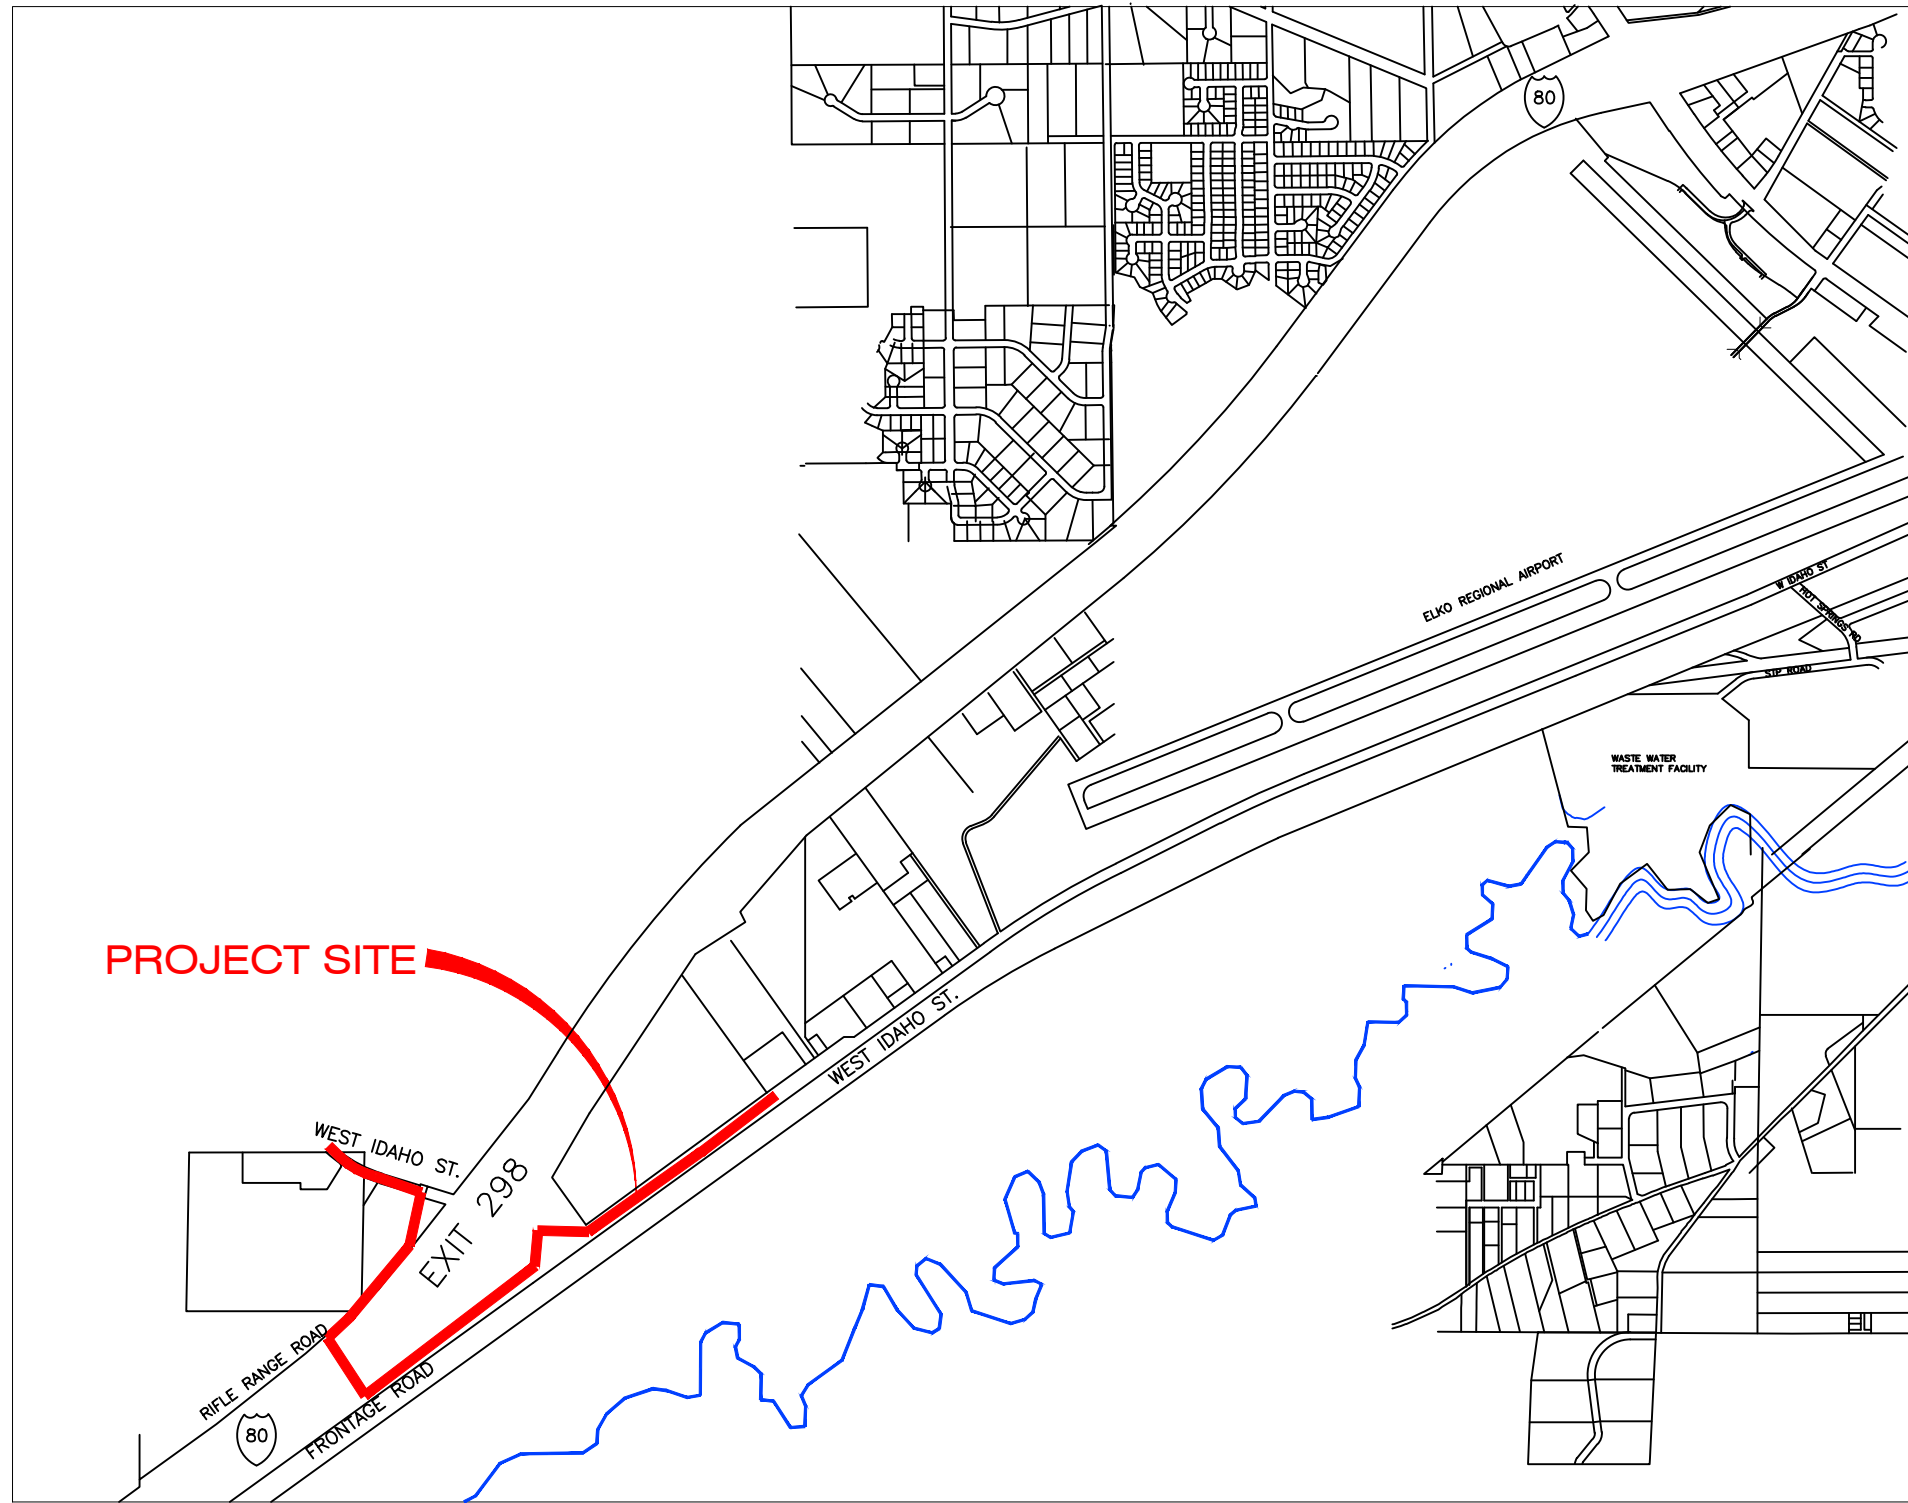

VICINITY MAP

GENERAL NOTES:

- IN GENERAL HYDRANTS SHOULD BE LOCATED A MINIMUM DISTANCE OF SIX FEET FROM ABOVE GROUND UTILITIES.
- WATER TAPS ONTO THE WATER MAIN ARE TO BE IN ACCORDANCE WITH CITY DETAIL U-12.1
- WATER TAPS ONTO THE WATER MAIN ARE TO BE A MINIMUM OF SIX FEET FROM HYDRANT TAPS
- ABOVE GROUND UTILITIES ARE NOT PERMITTED WITHIN THE RIGHT-OF-WAY.
- THE OWNER WILL PROVIDE AN AS-BUILT TO THE CITY OF ELKO AND N.D.O.T. THE AS-BUILT WILL INCLUDE ALL RELEVANT QUALITY ASSURANCE AND QUALITY CONTROL INFORMATION AND BE STAMPED BY A PROPERLY LICENSED PROFESSIONAL ENGINEER. THE CONTRACTOR SHALL WORK WITH THE PROJECT ENGINEER TO ENSURE ACCURATE AS-BUILT CAN BE GENERATED AND SUBMITTED TO THE CITY OF ELKO AND N.D.O.T. BY THE PROJECT ENGINEER.
- THE CONTRACTOR SHALL HAVE A STAMPED AGENCY APPROVED SET OF PLANS AT THE WORK SITE DURING CONSTRUCTION. CONSTRUCTION SHALL NOT PROCEED UNTIL THIS SET OF PLANS IS ISSUED WITH INCLUDED REVISIONS AND COMMENTS MADE BY THE AGENCIES.
- THE CONTRACTOR SHALL MAINTAIN A 24-HOUR DUST CONTROL PROGRAM INCLUDING WATERING OF OPEN AREAS. DUST CONTROL PROGRAM SHALL BE IN COMPLIANCE WITH ALL FEDERAL, STATE, COUNTY AND CITY CODES AND ORDINANCES.
- THE CONTRACTOR SHALL MAINTAIN AN ONGOING PROCESS FOR REMOVAL OF SPILLAGE OF EXCAVATED MATERIAL ON ALL PAVED STREETS.
- ALL CONSTRUCTION SHALL MEET THE REQUIREMENTS OF THE LATEST EDITION OF THE STANDARD SPECIFICATIONS & DETAILS FOR PUBLIC WORKS CONSTRUCTION-"ORANGE BOOK" AS PUBLISHED BY THE WASHOE COUNTY ETC.
- ALL AREAS DISTURBED AND LEFT UNDEVELOPED FOR A PERIOD OF MORE THAN 30 DAYS SHALL BE STABILIZED BY THE APPLICATION OF A DUST PALLIATIVE. ALL AREAS LEFT UNDEVELOPED FOR A PERIOD OF MORE THAN 90 DAYS SHALL BE HYDRO-SEEDED WITH AN APPROVED SEED MIX AND TACKIFIER AND SHALL BE IRRIGATED UNTIL FIRMLY ESTABLISHED AS APPROVED BY THE CITY OF ELKO.
- THE CONTRACTOR SHALL VERIFY IN THE FIELD, ALL ELEVATIONS, DIMENSIONS, FLOW LINES, EXISTING CONDITIONS, AND POINTS OF CONNECTIONS WITH ADJOINING PROPERTY (PUBLIC OR PRIVATE), ANY DISCREPANCIES SHALL BE CALLED TO THE ATTENTION OF THE PROJECT ENGINEER BEFORE PROCEEDING WITH THE WORK.
- THE CONTRACTOR SHALL NOTIFY THE PROJECT ENGINEER, THE SOILS ENGINEER, THE CITY OF ELKO, AND ALL UTILITY COMPANIES AT LEAST 48 HOURS PRIOR TO COMMENCEMENT OF WORK.
- THE CONTRACTOR SHALL CALL UNDERGROUND SERVICES ALERT AT 1.800.227.2600 AT LEAST 48 HOURS PRIOR TO COMMENCEMENT OF WORK.
- THE CONTRACTOR SHALL BE RESPONSIBLE FOR ANY AND ALL DAMAGE TO THE EXISTING UTILITIES ENCOUNTERED DURING CONSTRUCTION. IT SHALL BE THE CONTRACTOR RESPONSIBILITY TO CONTACT THE UTILITY COMPANIES FOR LOCATIONS PRIOR TO CONSTRUCTION. HORIZONTAL AND VERTICAL LOCATIONS OF EXISTING UTILITIES ARE APPROXIMATE ONLY.
- CONTRACTOR TO OBTAIN A STREET CUT PERMIT FROM THE PUBLIC WORKS DEPARTMENT AND PAY ANY APPLICABLE FEES TO THE CITY OF ELKO PRIOR TO EXCAVATING WITHIN THE CITY RIGHT OF WAY.
- CONTRACTOR SHALL OBTAIN ALL NECESSARY PERMITS FROM N.D.O.T. PRIOR TO WORK IN THEIR RIGHTS-OF-WAY.
- AT ALL POINTS WHERE SEWER (SANITARY OR STORM), WATER MAINS AND LATERALS CROSS, VERTICAL AND HORIZONTAL SEPARATION SHALL BE MAINTAINED PER NAC, ENGINEER AND CONTRACTOR TO REFERENCE SECTION 445A.6715 TO SECTION 445A.6718 OF THE NEVADA ADMINISTRATIVE CODE FOR UTILITY SEPARATION AND CLEARANCES.
- ALL SANITARY SEWER MAINS SHALL BE A MINIMUM OF 8" SDR 35 PVC (GREEN) PIPE. ALL RESIDENTIAL SANITARY SEWER LATERALS SHALL BE 4" SDR 35 PVC PIPE WITH A 2% SLOPE MINIMUM UNLESS OTHERWISE SHOWN. ALL COMMERCIAL SANITARY SEWER LATERALS SHALL BE 6" SDR 35 PVC PIPE WITH A 2% SLOPE MINIMUM UNLESS OTHERWISE SHOWN.
- ALL WATER MAINS SHALL BE A MINIMUM 10" DIAMETER, THICKNESS CLASS 50 OR PRESSURE CLASS 350 DUCTILE IRON PIPE, WITH POLYETHYLENE ENCASEMENT, OR DR 18 0900 PVC PIPE, UNLESS OTHERWISE SHOWN.
- MINIMUM COVER OVER THE WATER MAIN SHALL BE 42".
- THE CITY OF ELKO UTILITY DEPARTMENT SHALL BE CONTACTED TO PERFORM ALL TAPS ONTO CITY OF ELKO UTILITIES.
- THE CITY OF ELKO UTILITY DEPARTMENT SHALL BE CONTACTED FOR AUTHORIZATION TO PLACE ANY NEW WATER SYSTEMS, EXTENSIONS, REPLACEMENTS IN EXISTING SYSTEMS AND VALVED SECTIONS INTO SERVICE FOR TESTING OR FINAL ACCEPTANCE.
- ALL WATER SERVICE LINES SHALL BE 1" IRON PIPE SIZE (IPS), RATED 200 PSI POLYETHYLENE UNLESS OTHERWISE SHOWN.
- BEFORE BEING CERTIFIED BY AN ENGINEER OR ACCEPTED BY THE CITY OF ELKO, ANY NEW WATER SYSTEMS, EXTENSIONS, REPLACEMENTS IN EXISTING SYSTEMS AND VALVED SECTIONS SHALL BE DISINFECTED IN ACCORDANCE WITH AWWA C-651-"DISINFECTING WATER MAINS".
- BEFORE BEING CERTIFIED BY AN ENGINEER OR ACCEPTED BY THE CITY OF ELKO, ANY NEW WATER SYSTEMS, EXTENSIONS, REPLACEMENTS IN EXISTING SYSTEMS AND VALVED SECTIONS SHALL BE PRESSURE TESTED IN ACCORDANCE WITH NAC445A.67145.7 (A) AND (B).
- BEFORE BEING CERTIFIED BY AN ENGINEER OR ACCEPTED BY THE CITY OF ELKO, ANY NEW SEWER SYSTEMS, EXTENSIONS, REPLACEMENTS IN EXISTING SYSTEMS SHALL BE PRESSURE TESTED IN ACCORDANCE WITH THE STANDARD SPECIFICATIONS FOR PUBLIC WORKS CONSTRUCTION; LATEST EDITION.
- A TRAFFIC CONTROL PLAN SHALL BE PROVIDED BY THE CONTRACTOR AND APPROVED BY THE CITY OF ELKO AND N.D.O.T. PRIOR TO CONSTRUCTION.
- ALL WATER MAIN EXTENSIONS ARE TO BE TESTED IN ACCORDANCE WITH AWWA STANDARD C651 REQUIRING TWO SETS OF CONSECUTIVE SAMPLES AT LEAST 24 HOURS APART FROM EVERY 1200 FEET OF MAIN.

BASIS OF BEARING:

NORTH AMERICAN DATUM OF 1983/2007 PER THE NATIONAL GEODETIC SURVEY'S (NGS) PUBLISHED COORDINATES FOR NGS STATION "FUZZY", A STANDARD BRONZE DISK STAMPED "FUZZY 1967" SET IN THE TOP OF A ROUND CONCRETE POST WHICH PROJECTS 2 INCHES ABOVE THE GROUND. OF LATITUDE 40° 54' 25.01325N, LONGITUDE 115° 41' 47.528107W AND NEVADA STATE PLANE COORDINATE SYSTEM EAST ZONE GRID COORDINATES OF 28,488,522.75N, 624,878,27E. GROUND COORDINATES ARE USED HEREIN AND REFLECT GRID COORDINATES MULTIPLIED BY THE CITY OF ELKO ACCEPTED COMBINED GRID TO GROUND SCALE FACTOR OF 1.000357 WITH THE RESULTING GROUND COORDINATES FOR NGS "FUZZY" BEING 28,498,693.15N, 625,101.35E.

BASIS OF ELEVATION:


NORTH AMERICAN VERTICAL DATUM OF 1988, PER THE NATIONAL GEODETIC SURVEY'S (NGS) PUBLISHED ELEVATION FOR NGS BENCHMARK B 52, A STABILITY CLASS A MARK STAMPED "B 52 1934" SET VERTICALLY IN THE NORTHWEST WALL OF THE ELKO MAIN POST OFFICE (BRICK WITH STONE CORNERS), 0.9 FOOT SOUTH-WEST OF THE NORTH CORNER, AND 4 FEET ABOVE THE GROUND.

SHEET INDEX:

TITLE SHEET	1
KEY SHEET	2
PLAN AND PROFILE	3
PLAN AND PROFILE	4
PLAN AND PROFILE	5
PLAN AND PROFILE	6
PLAN AND PROFILE	7
PLAN AND PROFILE	8
PLAN AND PROFILE	9
DETAIL SHEET	10

ABBREVIATION

AC	ASPHALT CONCRETE	GB	GRADE BREAK	R	RADIUS
ACP	ASBESTOS CEMENT PIPE	GDW	GRAVEL DRIVEWAY	RCP	REINFORCED CONCRETE PIPE
AGG	AGGREGATE	GO	GROUND	REF	REFERENCE
BC	BEGIN CURVE (HORIZONTAL)	GV	GATE VALVE	RET	CURB RETURN
BF	BACK OF WALK	H	HANDICAPPED	RP	RADIUS POINT
BOW	BOTTOM OF FOOTING	HCL	HYDRAULIC GRADE LINE	RT	RIGHT
BV	BUTTERFLY VALVE	HORIZ	HORIZONTAL	R/W, ROW	RIGHT-OF-WAY
BVC	BEGIN VERTICAL CURVE	HP	HIGH POINT	S	SLOPE (FT./FT.)
BF, BOF	BOTH WAYS	ID	INSIDE DIAMETER	SD	SOUTH
CB	CATCH BASIN	IE	INVERT ELEVATION	SD	STORM DRAIN
C&G	CUBIC FEET PER SECOND	INT	INTERSECTION	SDMH	STORM DRAIN MANHOLE
C&G	CURB AND GUTTER	IRR	IRRIGATION	SL	STREET LIGHT
CL	CENTER LINE	LAT	LATERAL	SS	SANITARY SEWER
CMP	CORRUGATED METAL PIPE	LF	LINEAR FEET	SSCO	SANITARY SEWER CLEAN OUT
COMP	COMPACTION	LP	LOW POINT	SSMH	SANITARY SEWER MANHOLE
CONC	CONCRETE	LT	LEFT	SSPWC	STANDARD SPEC. for PUBLIC WORKS' CONST.
CONTR/CTR	CONTRACTOR	MAX	MAXIMUM	SW	SIDEWALK
CP	CONCRETE PAD	MH	MANHOLE	TELE	TELEPHONE
CTV	CABLE TELEVISION	MIN	MINIMUM	TBO	TEMPORARY BLOW OFF VALVE
DI	DROP INLET	MJ	MECHANICAL JOINT	TR	TOP OF CURB
DIA	DIAMETER	MMD	MAXIMUM MARSHALL DENSITY	TG	TOP OF WALL
DWY	DRIVEWAY	MUTCD	MANUAL FOR TRAFFIC CONTROL DEVICES	TGB	TOP OF BERM
E	EACH	N	NORTH	TF, TOW	TOP OF FOOTING
EA	END CURVE (HORIZONTAL)	NAP	NOT A PART	TS	TOP OF WALL
EC	END CURVE (HORIZONTAL)	NIP	NOT IN PROJECT	TSCB	TRAFFIC SIGNAL
ELL	ELBOW	NTS	NOT TO SCALE	TR	TRAFFIC SIGNAL CONTROL BOX
ELEC	ELECTRICAL	OC	ON CENTER	TRANS	TRANSITION
ELEV	ELEVATION	OD	OUTSIDE DIAMETER	TYP	TYPICAL
EVC	END VERTICAL CURVE	OH	OVERHEAD	USE/P	UNDER GROUND POWER
EX, EXIST, (E)	EXISTING	OP	PROPOSED	UNO	UNLESS NOTED OTHERWISE
EXT	EXTERIOR	PCC	PORTLAND CEMENT CONCRETE	V	VELOCITY AT 5 YEAR PEAK
FCA	FLANGE COUPLING ADAPTER	PG	PAD GRADE	VC	VERTICAL CURVE
FES	FINISH ELEVATION	PI	POINT OF INTERSECTION	VEL	VELOCITY
FF	FLARED END SECTION	PVC	POINT OF INTERSECTION VERTICAL CURVE	VERT	VERTICAL
FL	FINISH FLOOR	PL	PROPERTY LINE	VG	VALLEY GUTTER
FFC	FRONT FACE OF CURB	POCC	POINT OF COMPOUND CURVATURE	W	WEST
FG	FINISH GRADE	POT	POINT OF TANGENCY	W/G	WATER AND GAS
FH	FIRE HYDRANT	PP	POWER POLE	WL	WATER LINE
FL	FLOW LINE	PRC	POINT OF REVERSE CURVE	WM	WATER METER
FLG	FLANGE	PRVC	POINT OF REVERSE VERTICAL CURVE	WS	WATER SURFACE
fps	FEET PER SECOND	PVC	POLYVINYL CHLORIDE	WV	WATER VALVE
FTG	FOOTING	PVMT	PAVEMENT	WWF	WELDED WIRE FABRIC
G	GAS	Q5	5 YEAR PEAK FLOW		
GALV	GALVANIZED	Q100	100 YEAR PEAK FLOW		

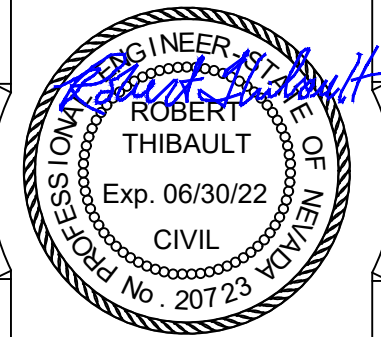

CITY OF ELKO
1751 COLLEGE AVE
ELKO, NEVADA 89801
(775) 777-7210
fax: (775) 777-7219

DESIGN BY:	BT
DRAWN BY:	ACAD_C3D_2020
CHECKED BY:	BT
DATE:	6/22/2022 8:30 AM
JOB NO.:	

REV	DATE	DESCRIPTION	BY	APVD
1	6/22/22	MINOR CHANGES TO REFLECT ADDENDUM ITEMS	BT	



SCALE	
HORIZ:	NONE
VERT:	NONE

EXIT 298 SEWER & WATER DESIGN
PHASE 2
TITLE SHEET

SHEET

1 of 10

U:\Streets\p and h Drive\pandh-Drive-6.dwg

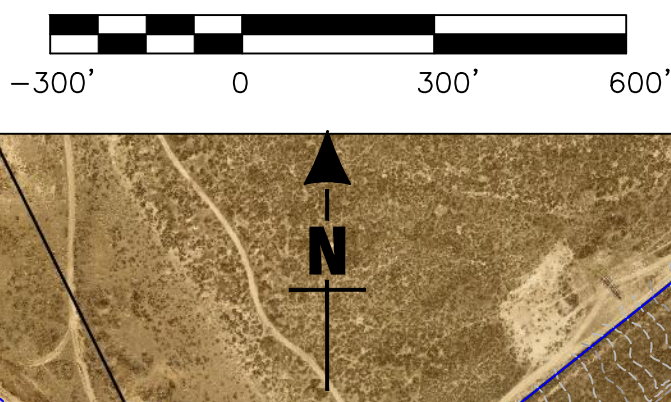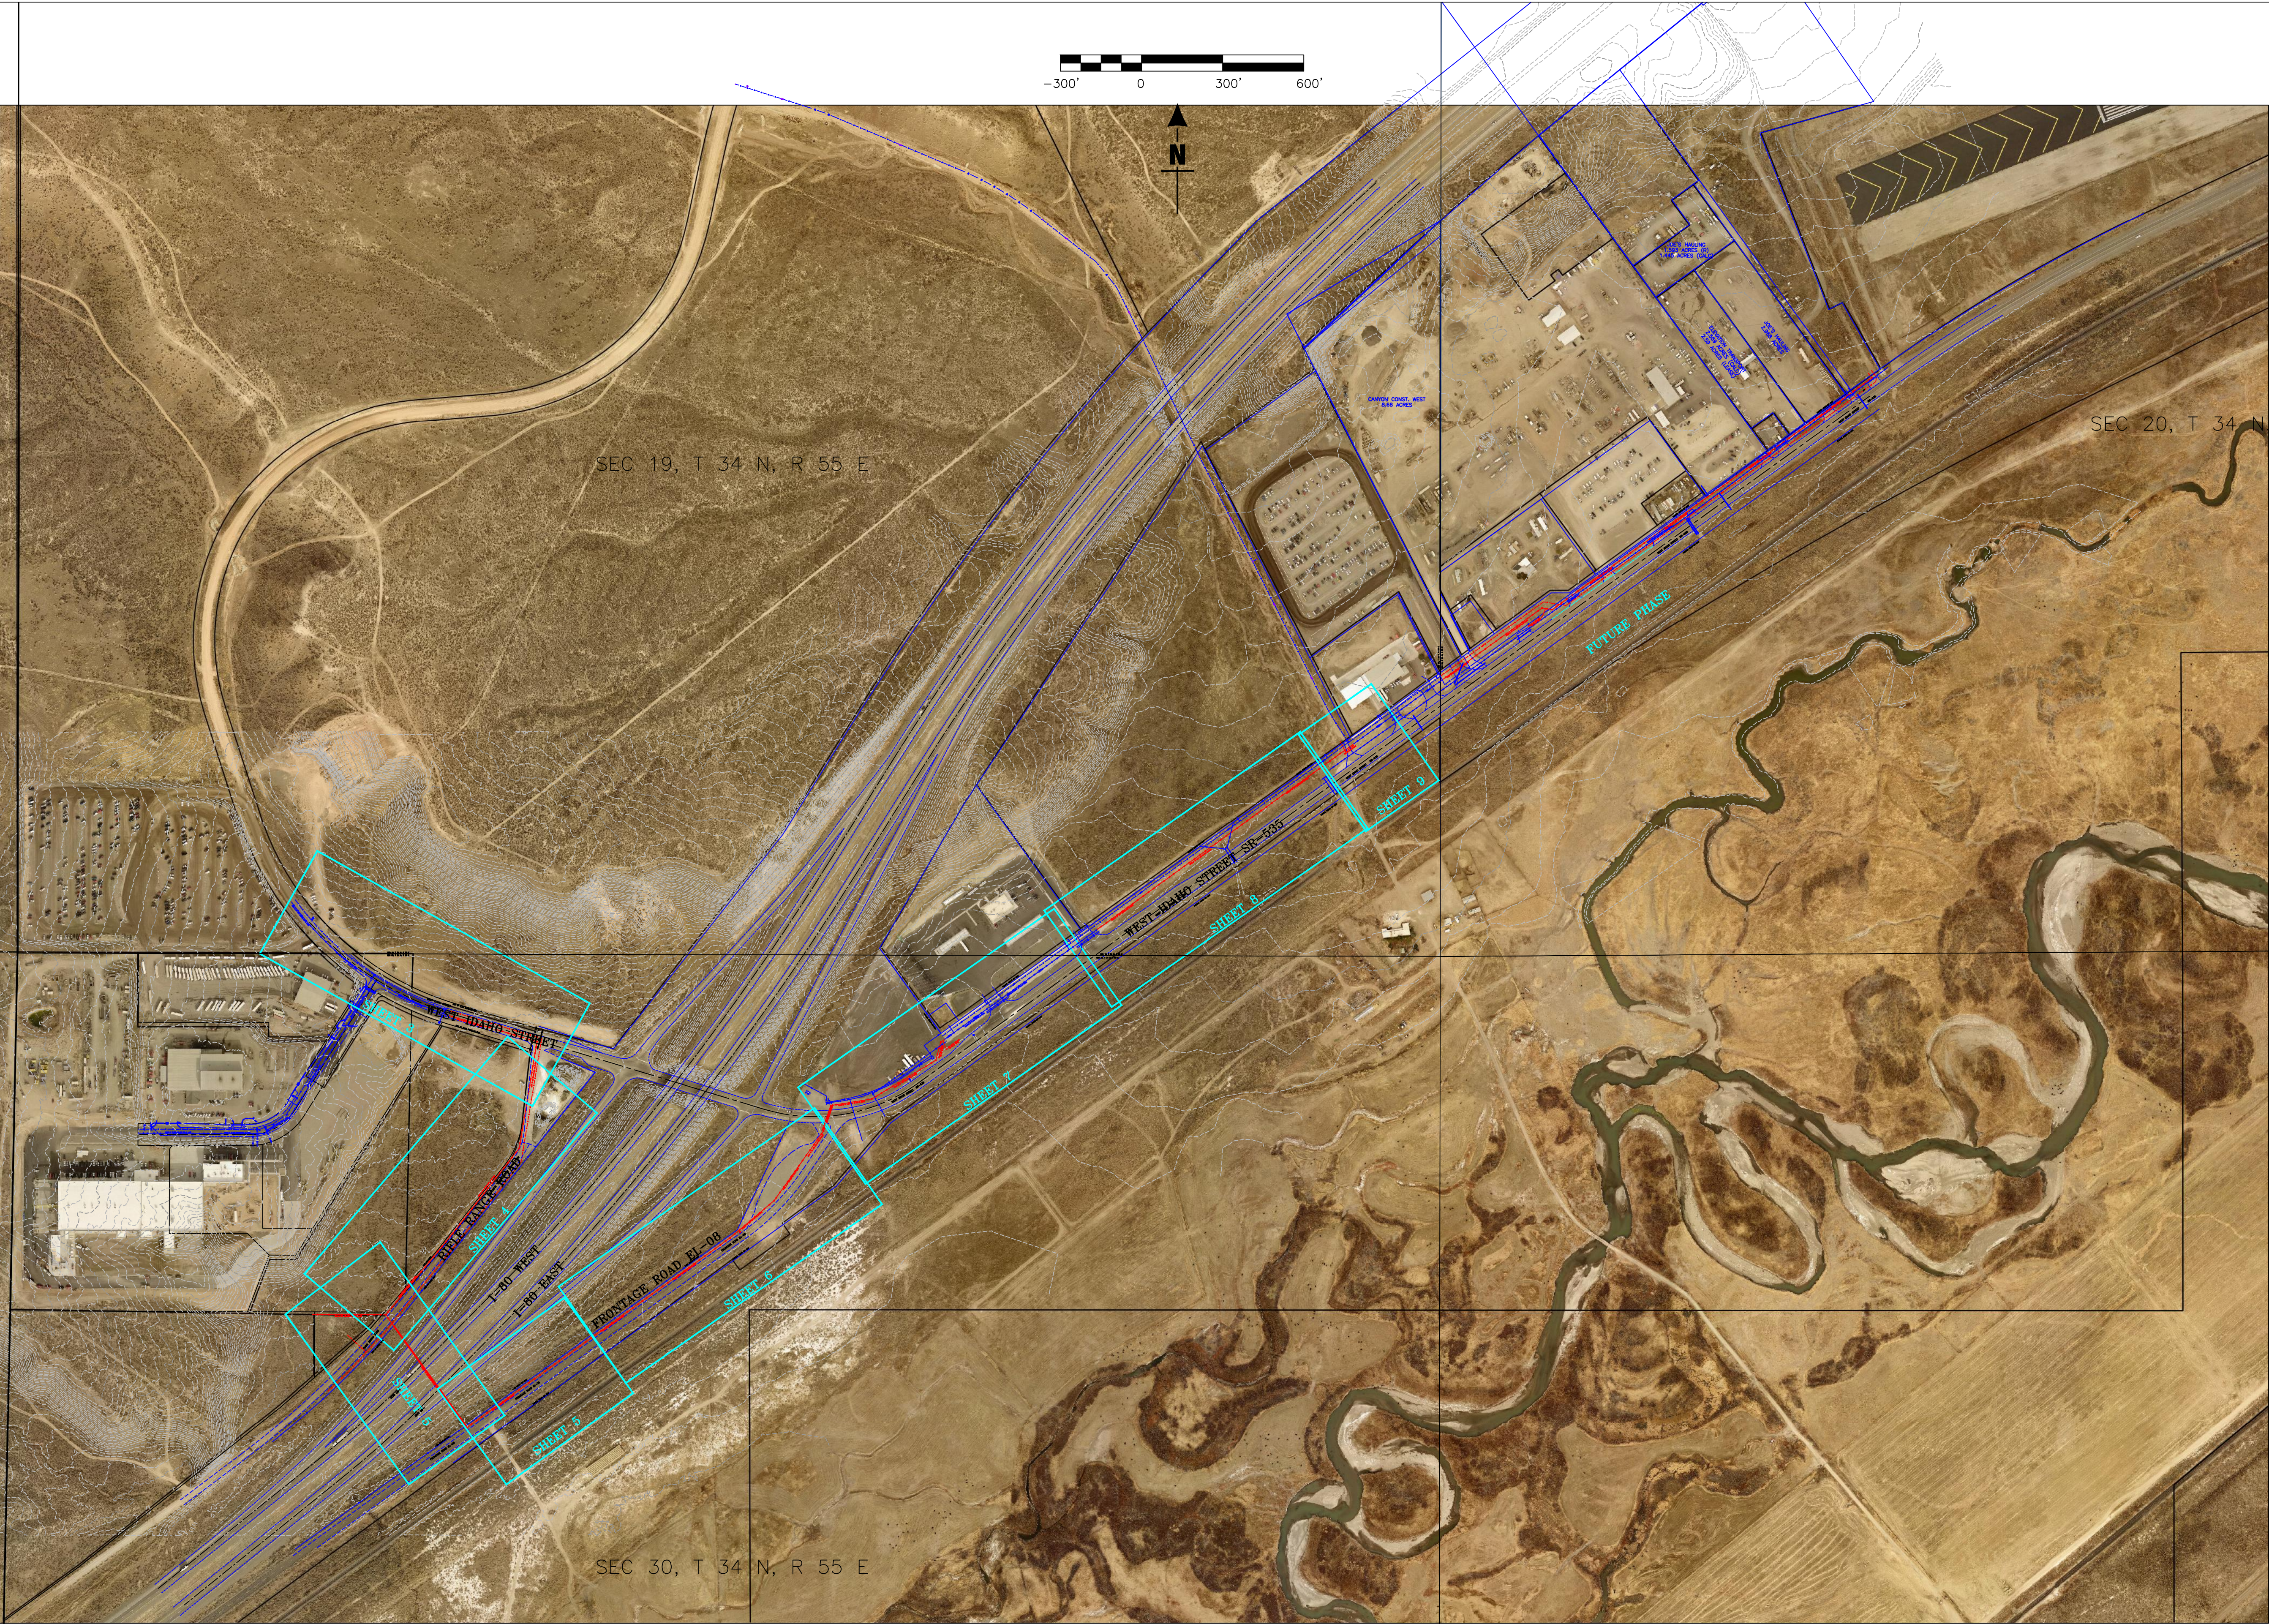

ENGINEER

ROBERT THIBAUT

Exp. 06/30/22

CIVIL

Job No. 20723

CITY OF ELKO

1751 COLLEGE AVE

ELKO, NEVADA 89801

(775) 777-7210

fax: (775) 777-7219

DESIGN BY: BT

DRAWN BY: ACAD_C3D_2020

CHECKED BY: BT

DATE: 6/2/2022 2:56 PM

JOB NO:

REV	DATE	DESCRIPTION	BY	APVD

SCALE

HORIZ: 1"=300'

VERT: NONE

EXIT 298 SEWER & WATER DESIGN

PHASE 2




KEY INDEX SHEET

ELKO ELKO COUNTY NEVADA

SHEET

2 of 10

U:\Streets\AP and H Drive\FondH-Drive-6.dwg

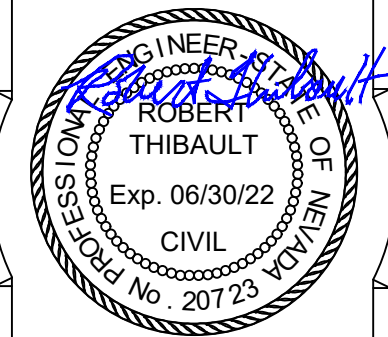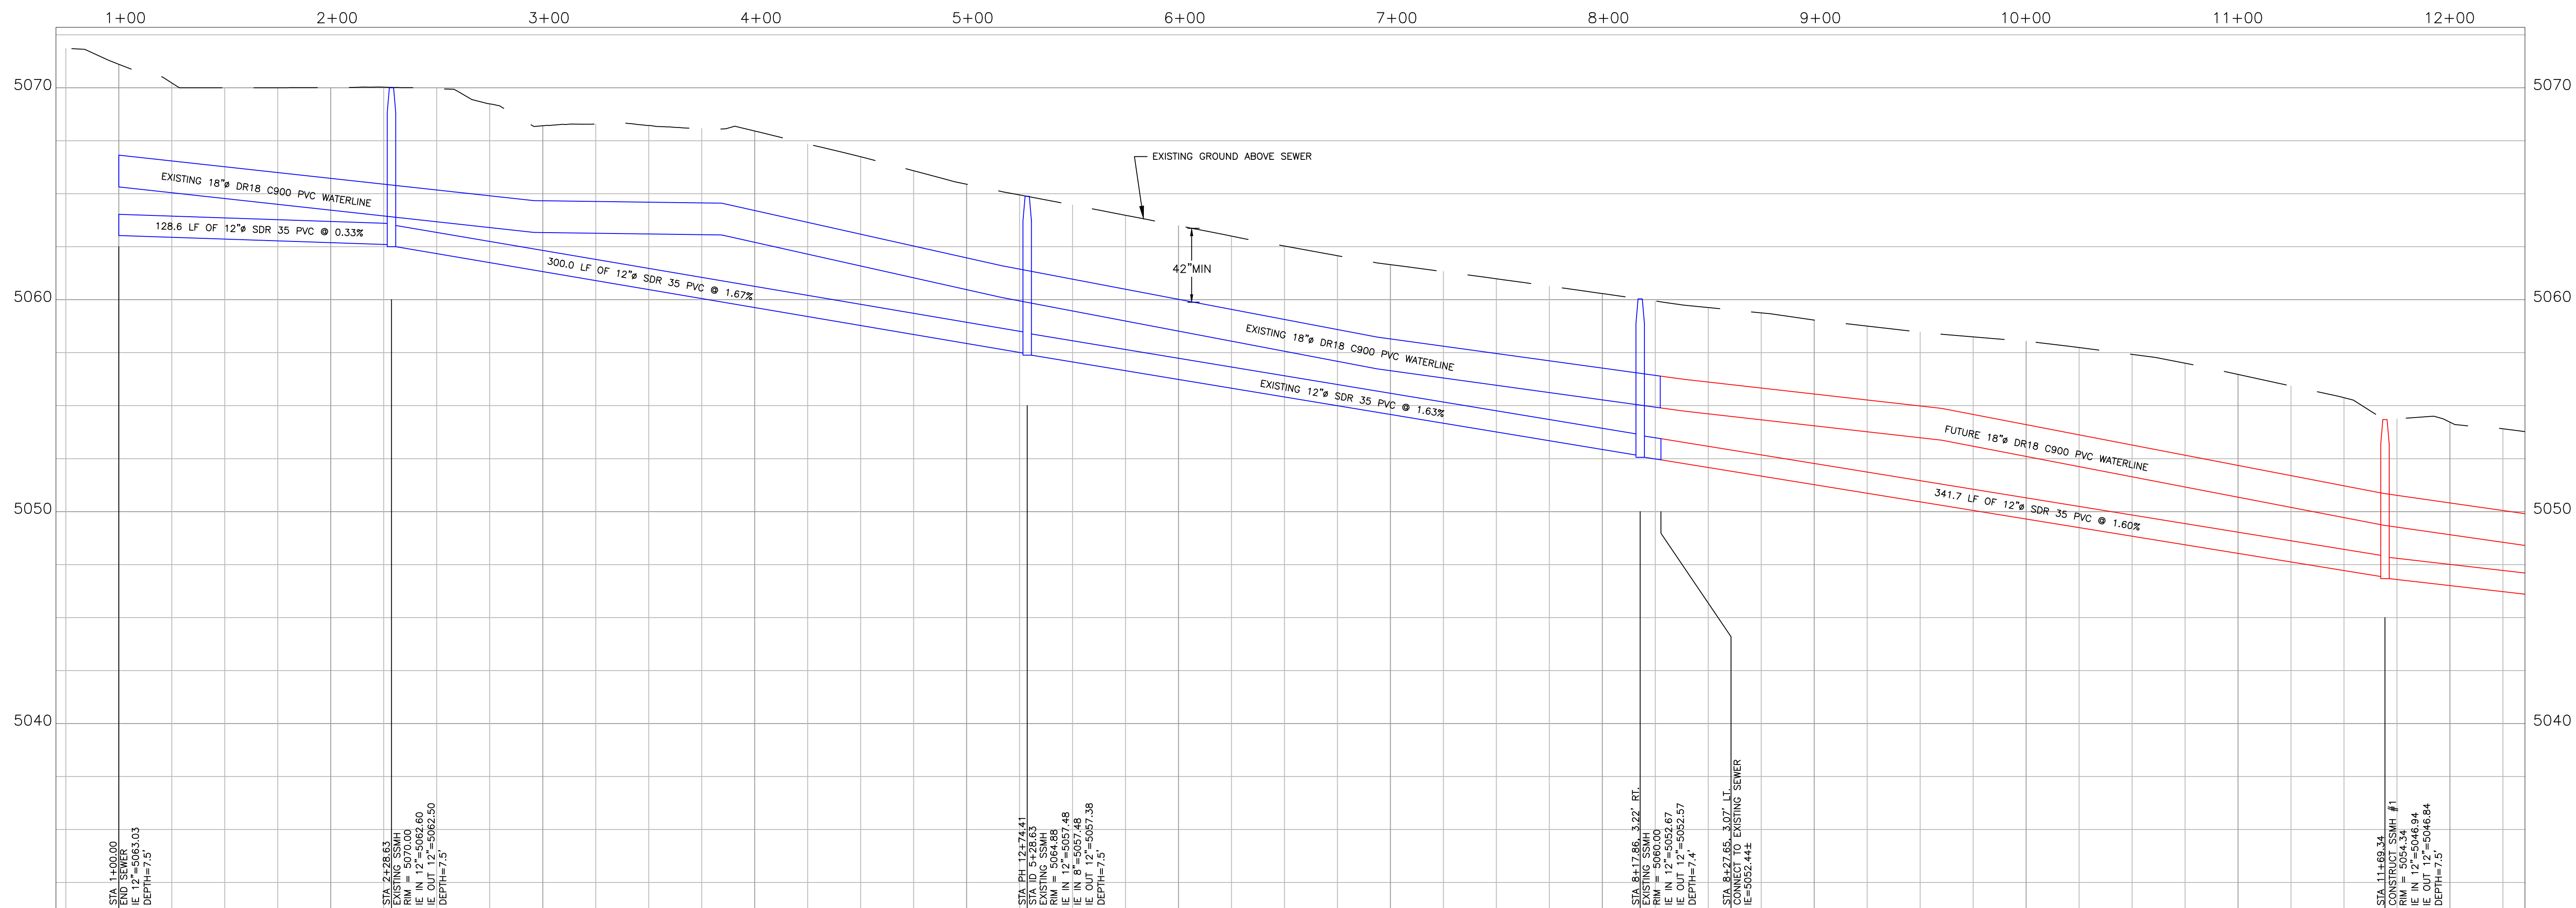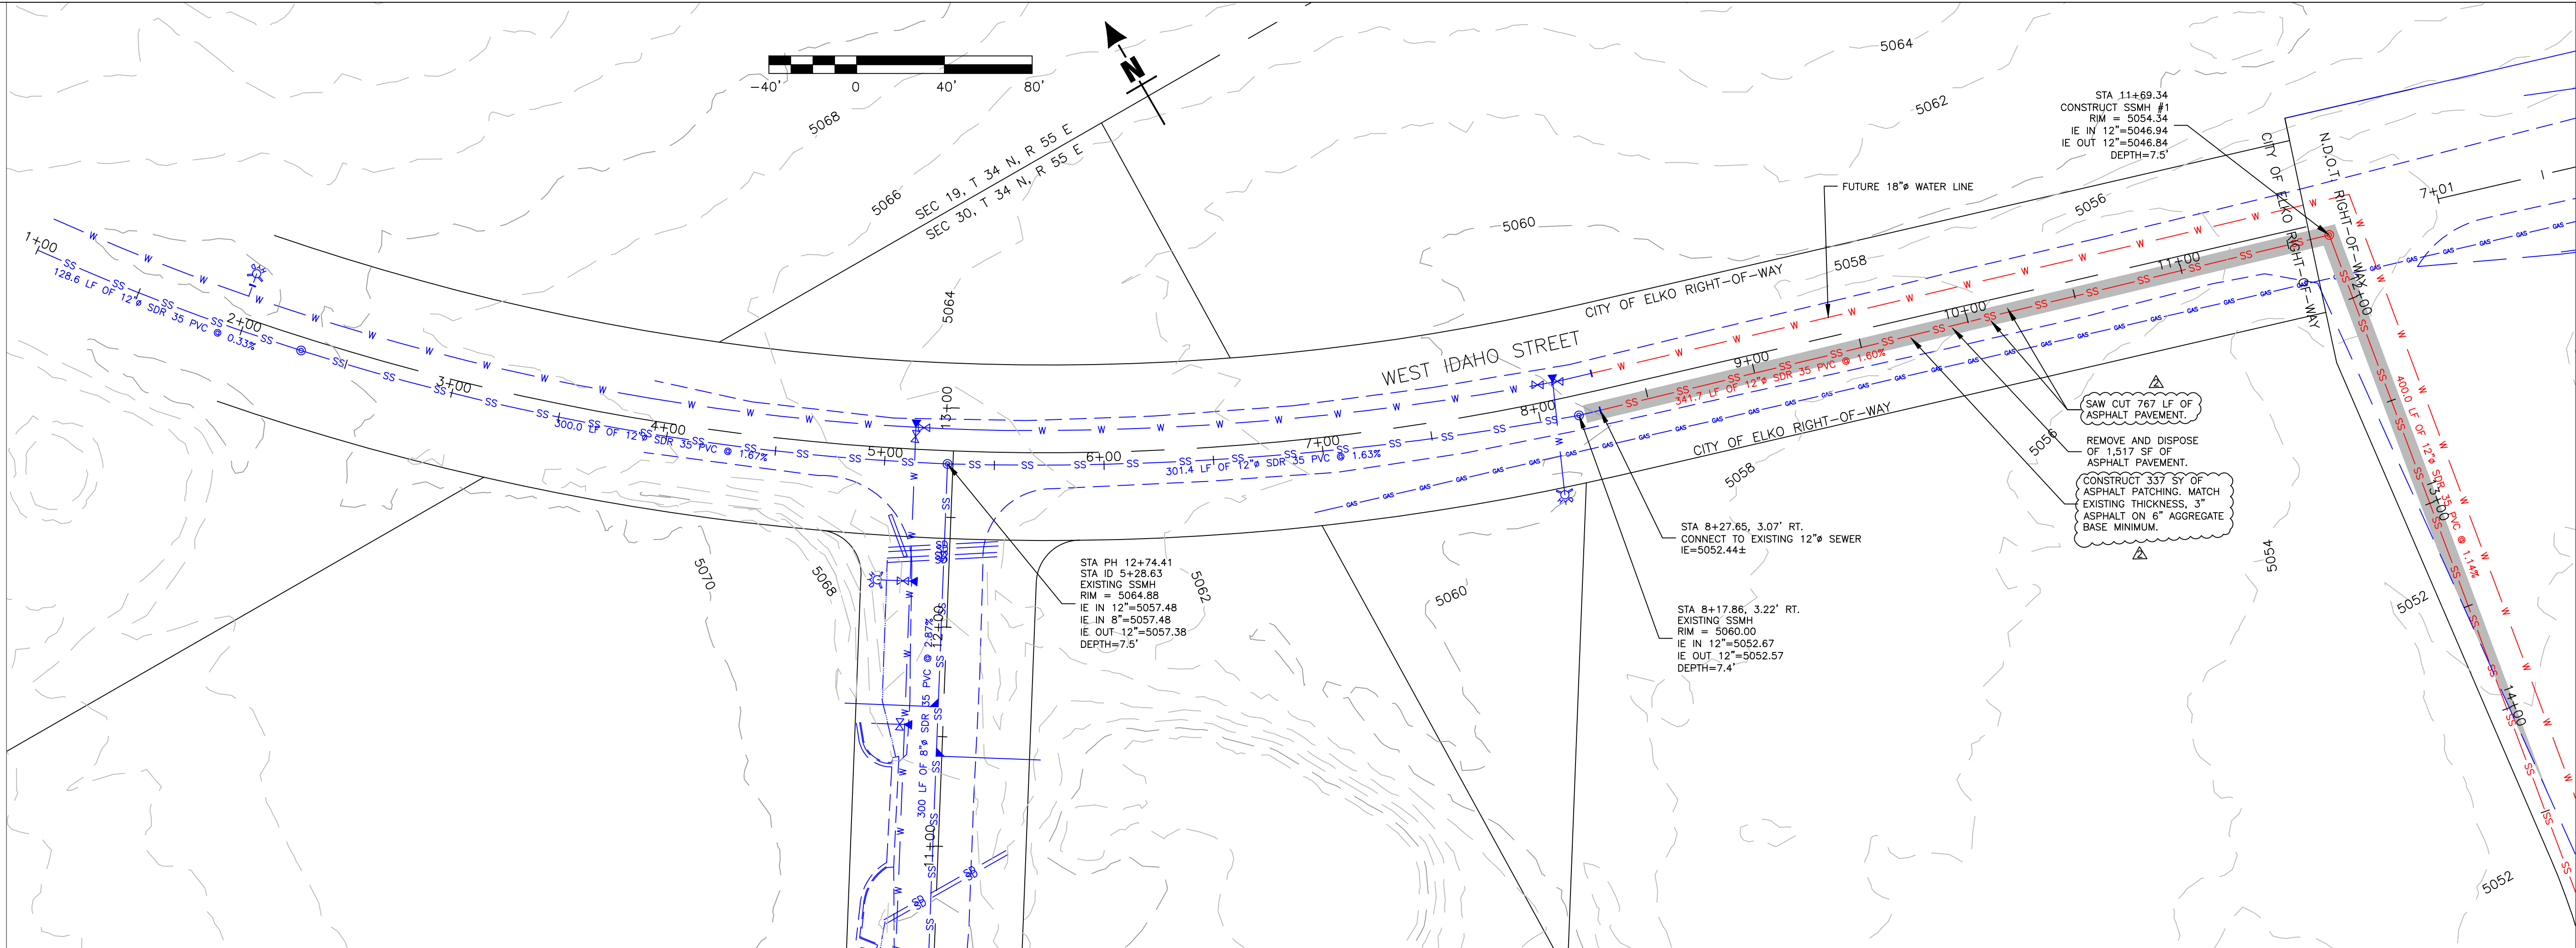

CITY OF ELKO
1751 COLLEGE AVE
ELKO, NEVADA 89801
(775) 777-7210
fax: (775) 777-7219

DESIGN BY: BT
DRAWN BY: ACAD_C3D_2020
CHECKED BY: BT
DATE: 6/23/2022 10:37 AM
JOB NO:

REV	DATE	DESCRIPTION	BY	APVD
1	6/22/22	MINOR CHANGES TO REFLECT ADDENDUM ITEMS	BT	BT
2	6/23/22	ASPHALT QUANTITY CHANGES PER ADDENDUM 3	BT	BT


SCALE
HORIZ: 1"=40'
VERT: NONE

EXIT 298 SEWER & WATER DESIGN
PHASE 2
WEST IDAHO STREET
PLAN AND PROFILE
ELKO COUNTY NEVADA


SHEET
3 OF 10

U:\Streets\p and h Drive\FordH-Drive-6.dwg

MATCH LINE 12+00
SEE SHEET 3

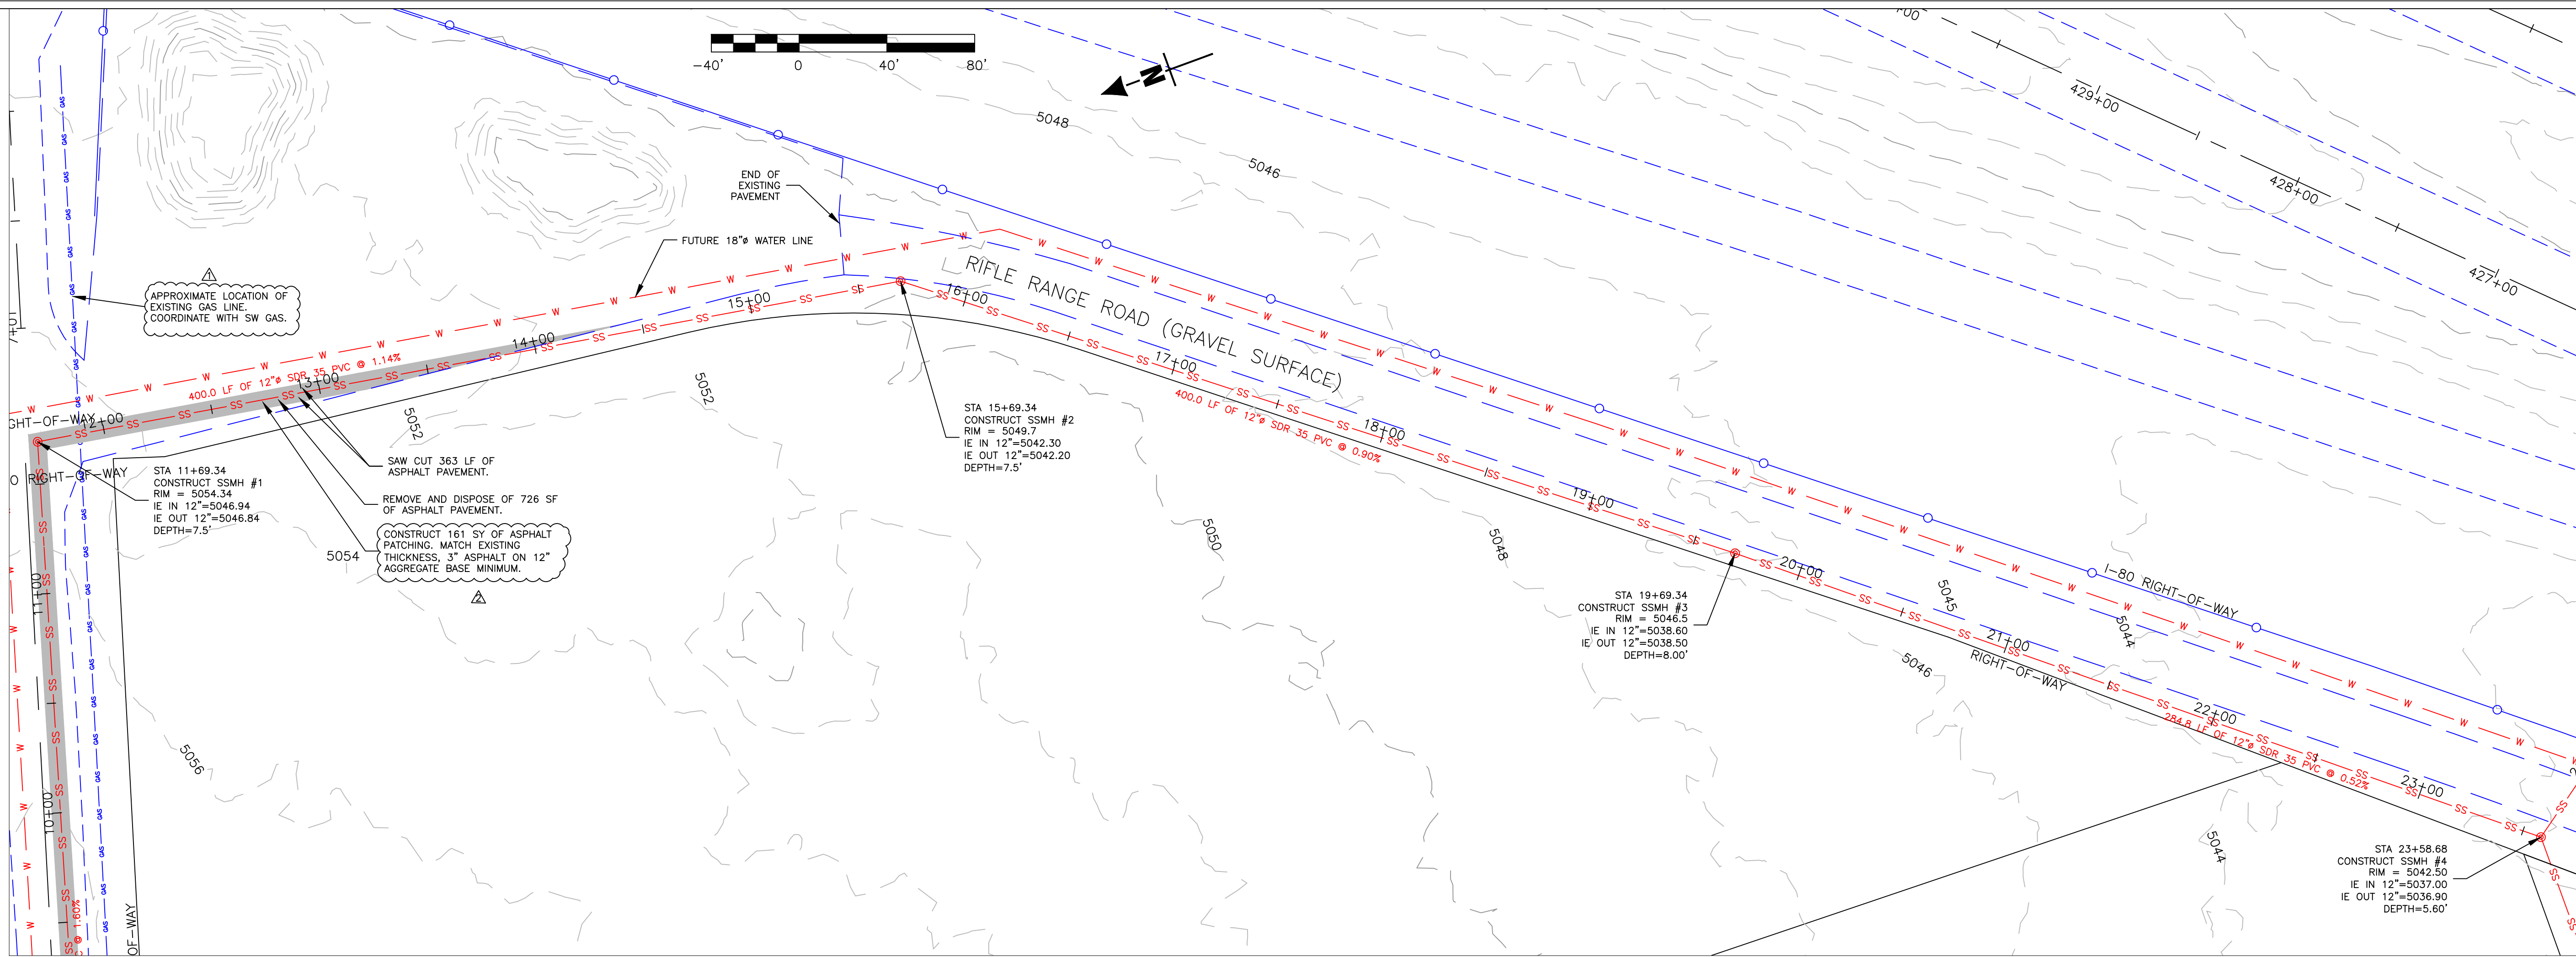

MATCH LINE 12+00
SEE SHEET 3

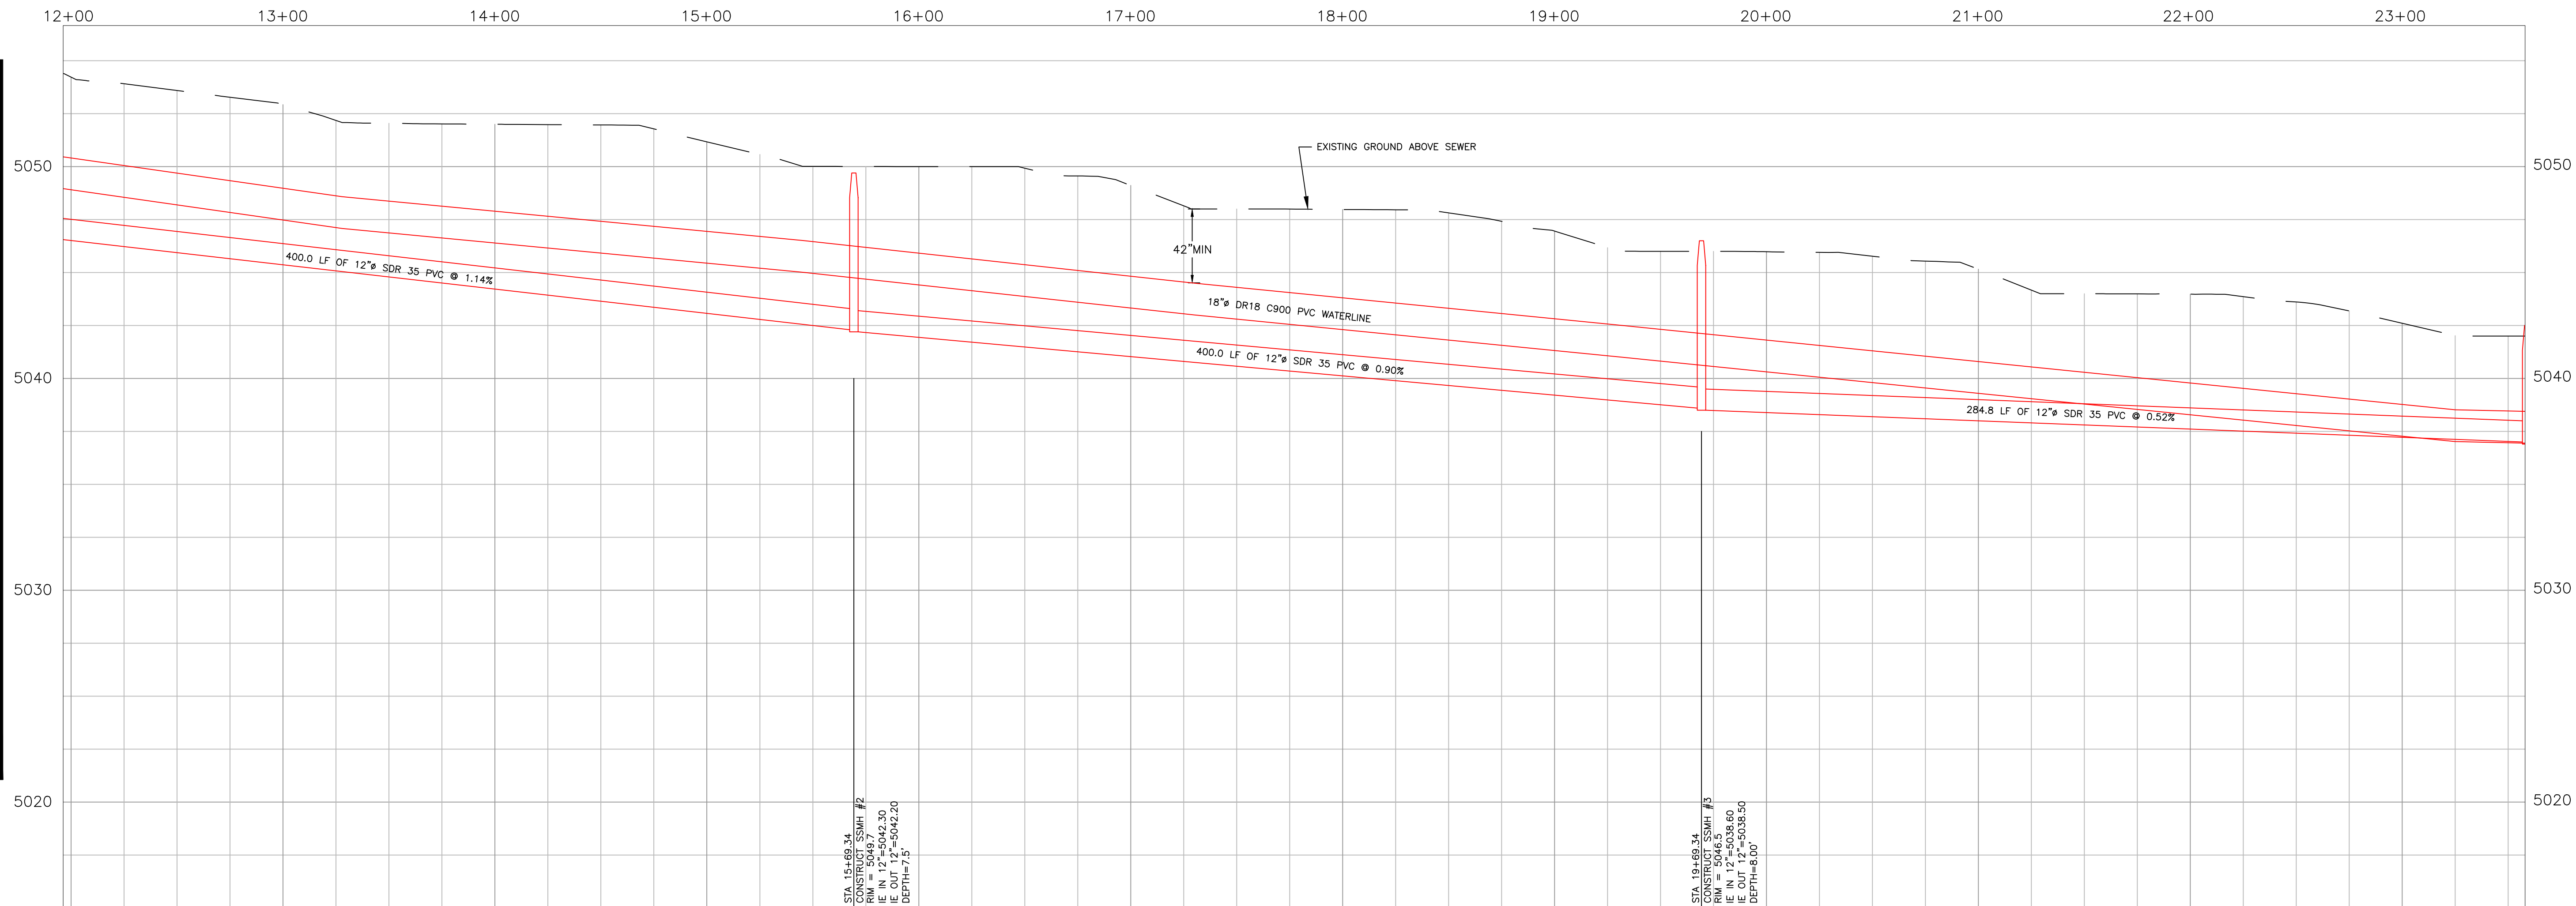

MATCH LINE 23+50
SEE SHEET 5

MATCH LINE 23+50
SEE SHEET 5

ENGINEER
ROBERT THIBAUT
Exp. 06/30/22
CIVIL
No. 20173
STATE OF NEVADA

CITY OF ELKO
1751 COLLEGE AVE
ELKO, NEVADA 89801
(775) 777-7210
fax: (775) 777-7219

DESIGN BY: BT

DRAWN BY: ACAD_C3D_2020

CHECKED BY: BT

DATE: 6/23/2022 10:38 AM

JOB NO:

REV	DATE	DESCRIPTION	BY	APVD
1	6/22/22	MINOR CHANGES TO REFLECT ADDENDUM ITEMS	BT	BT
2	6/23/22	ASPHALT QUANTITY CHANGES PER ADDENDUM 3	BT	BT

SCALE

HORIZ: 1"=40'

VERT: NONE

EXIT 298 SEWER & WATER DESIGN

PHASE 2

FRONTAGE ROAD

PLAN AND PROFILE

ELKO

ELKO COUNTY

NEVADA





SHEET

4 of 10

U:\Streets\A and H Drive\PendH-Drive-6.dwg

MATCH LINE 23+50
SEE SHEET 4

MATCH LINE 23+50
SEE SHEET 4

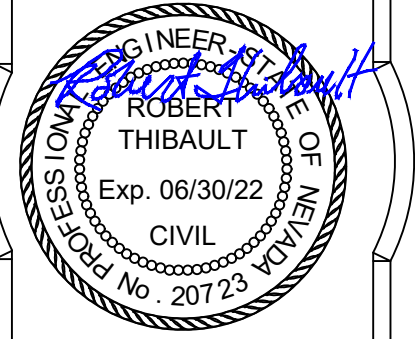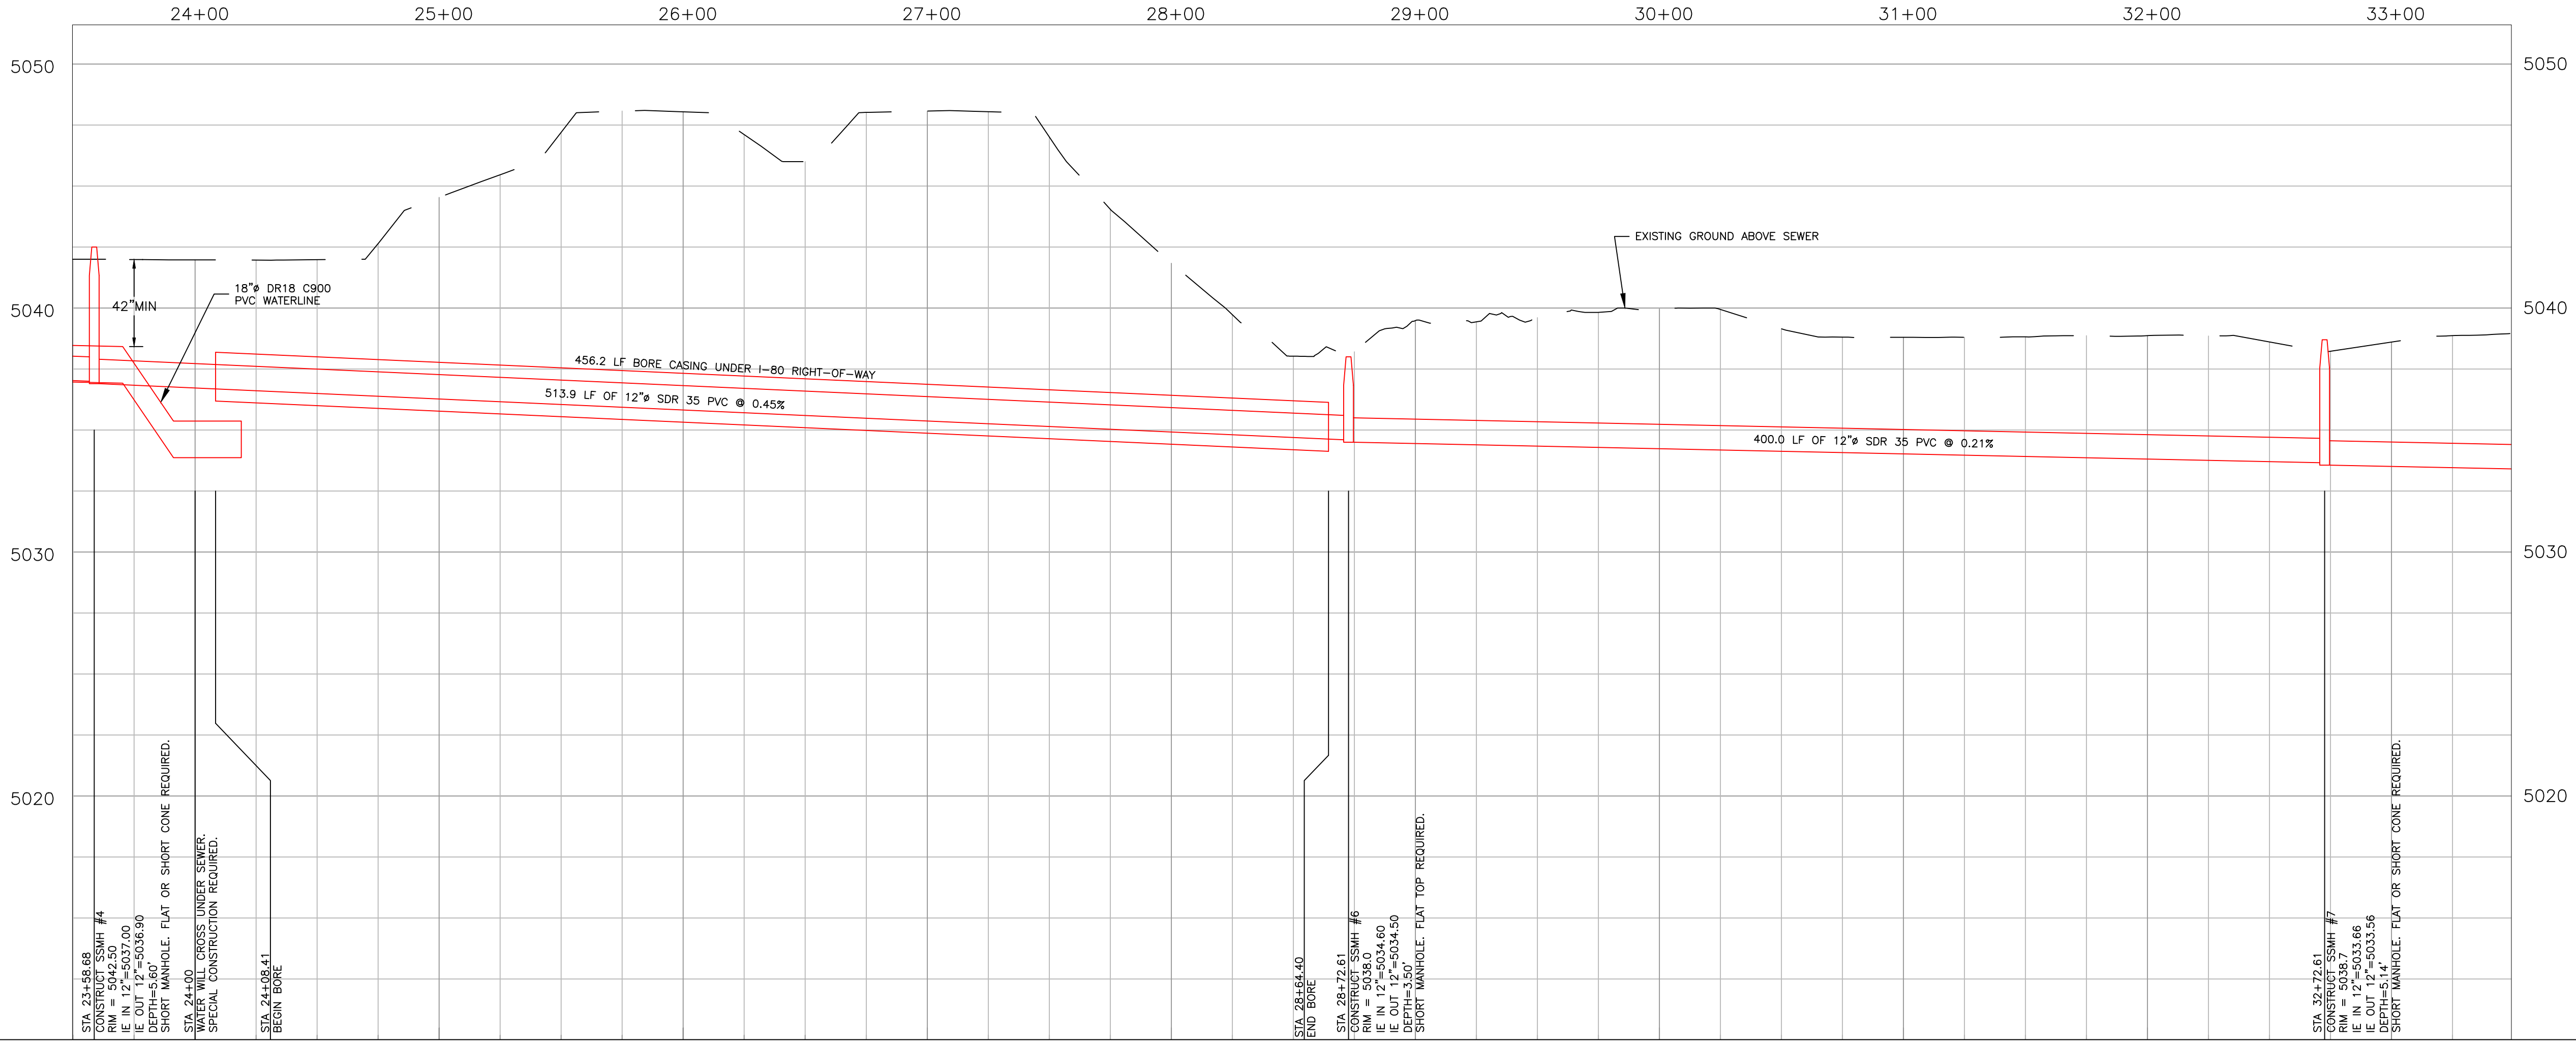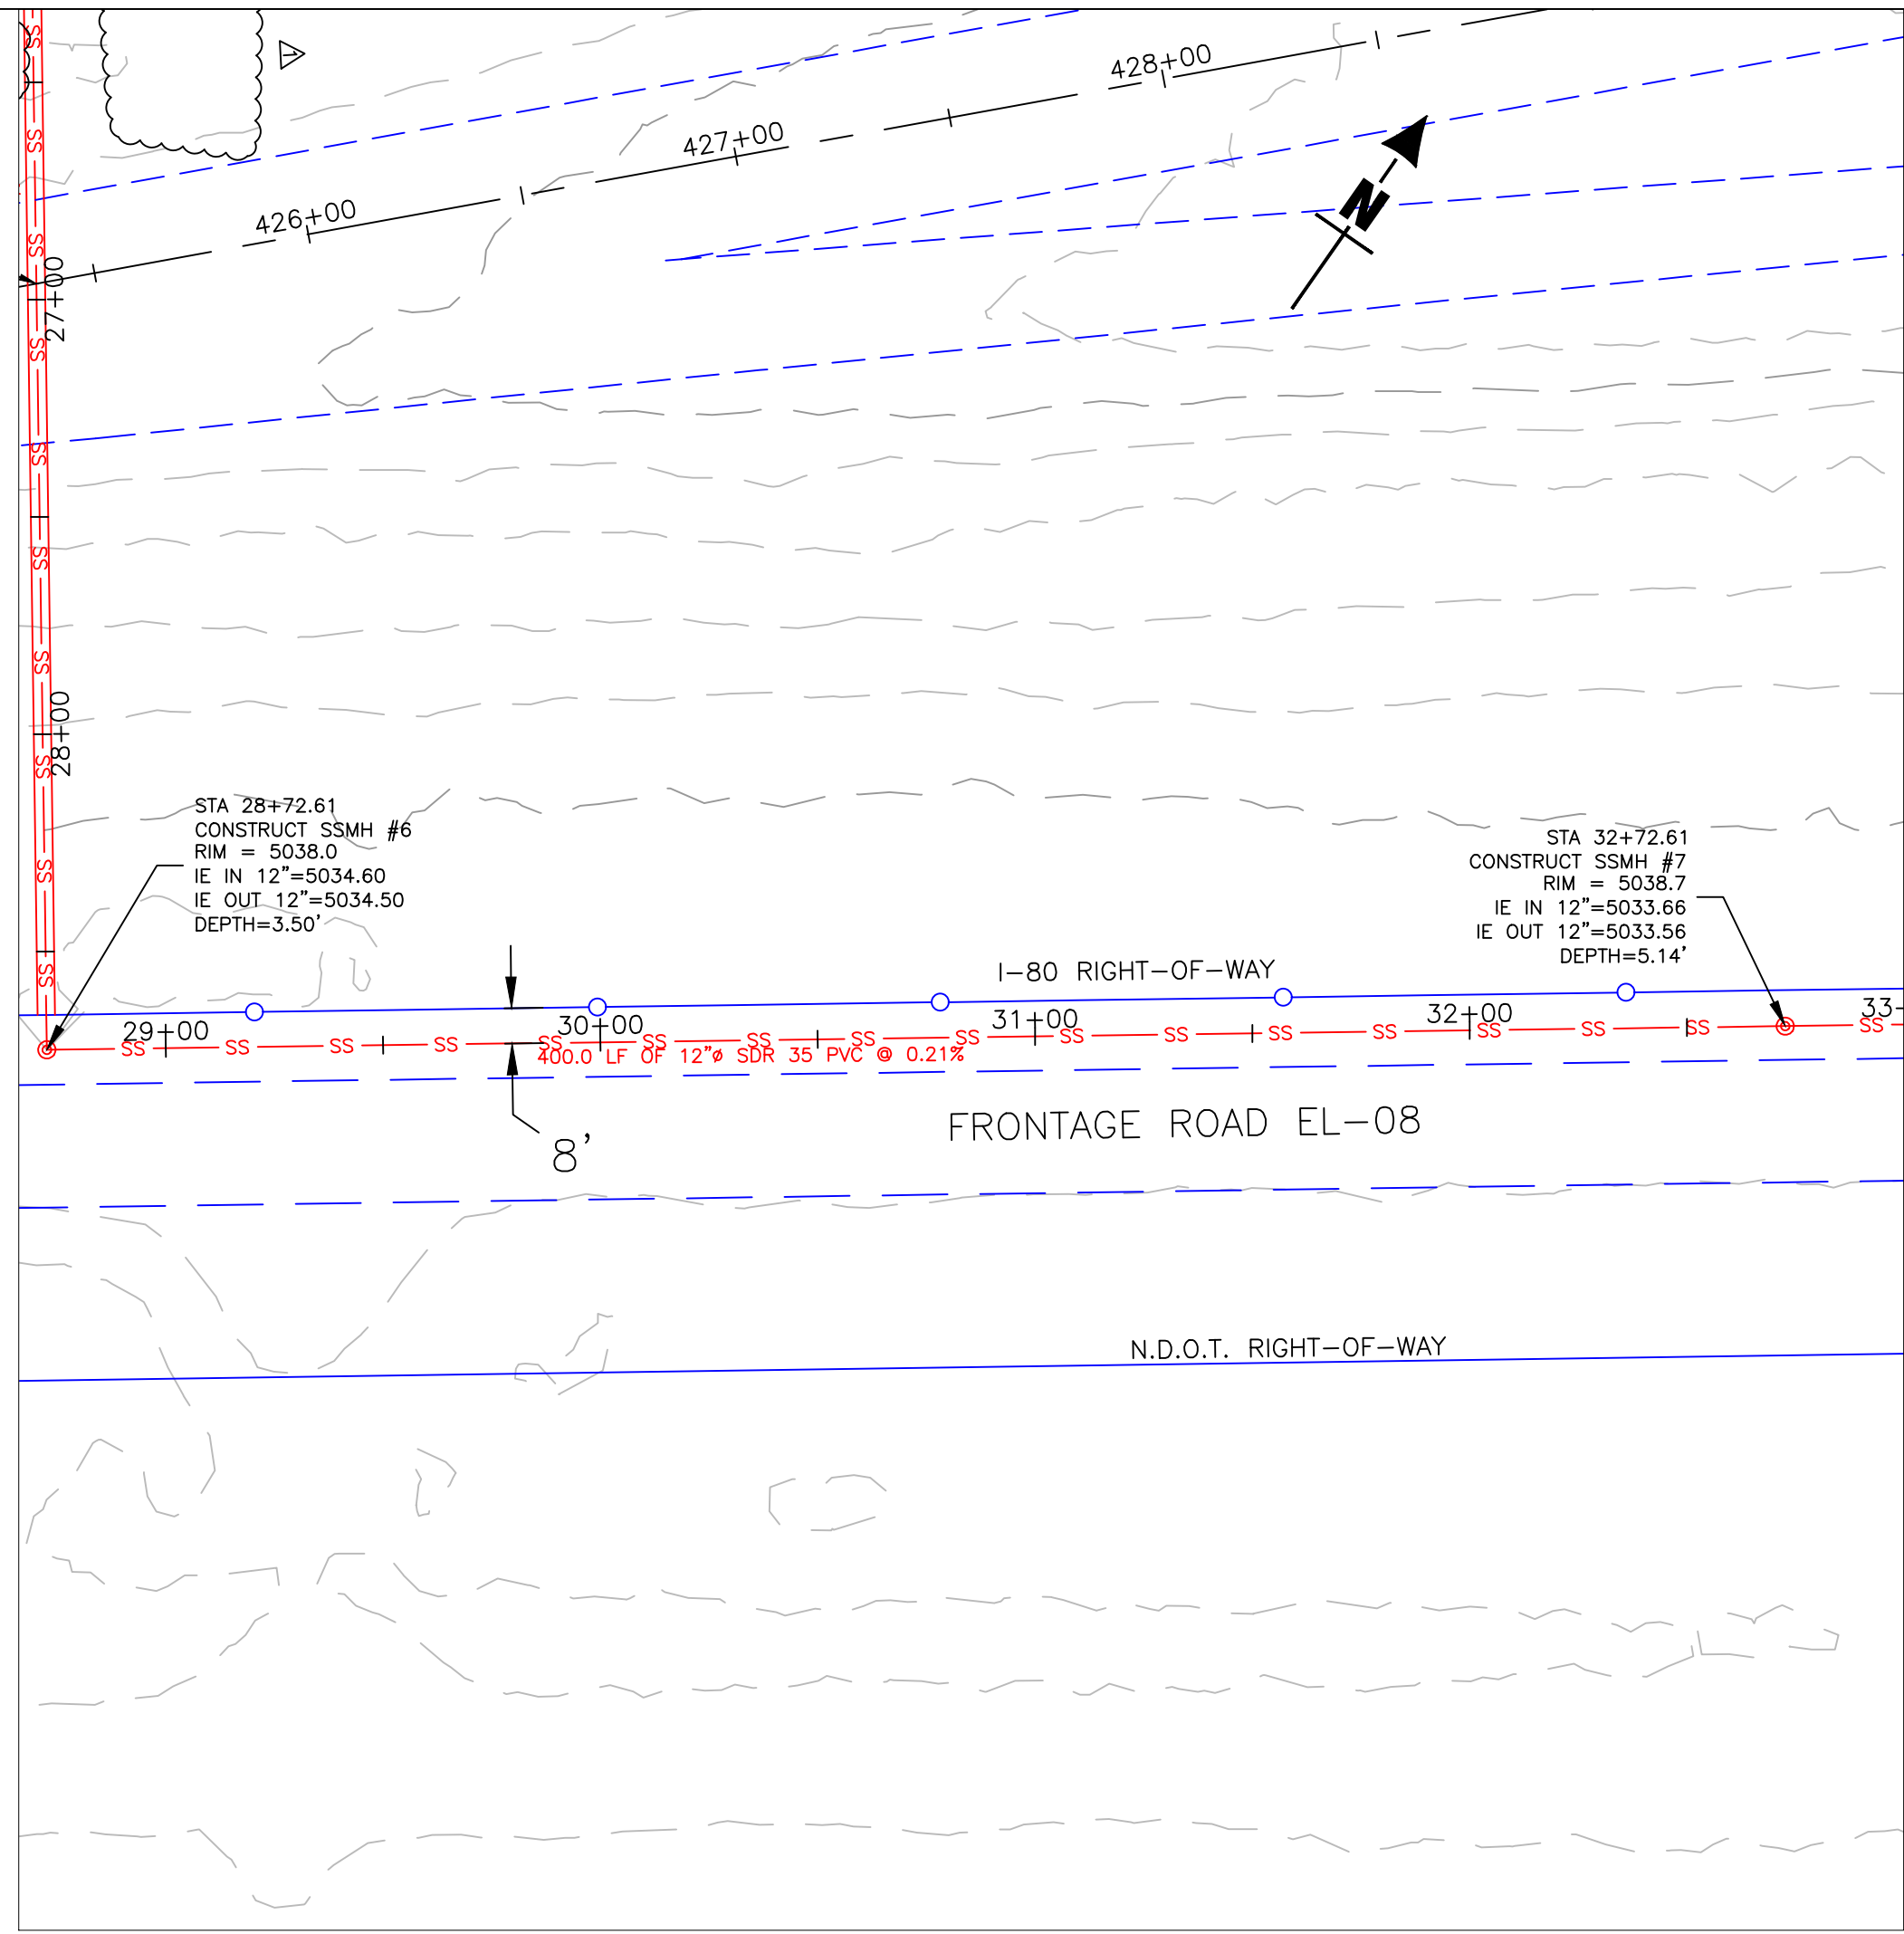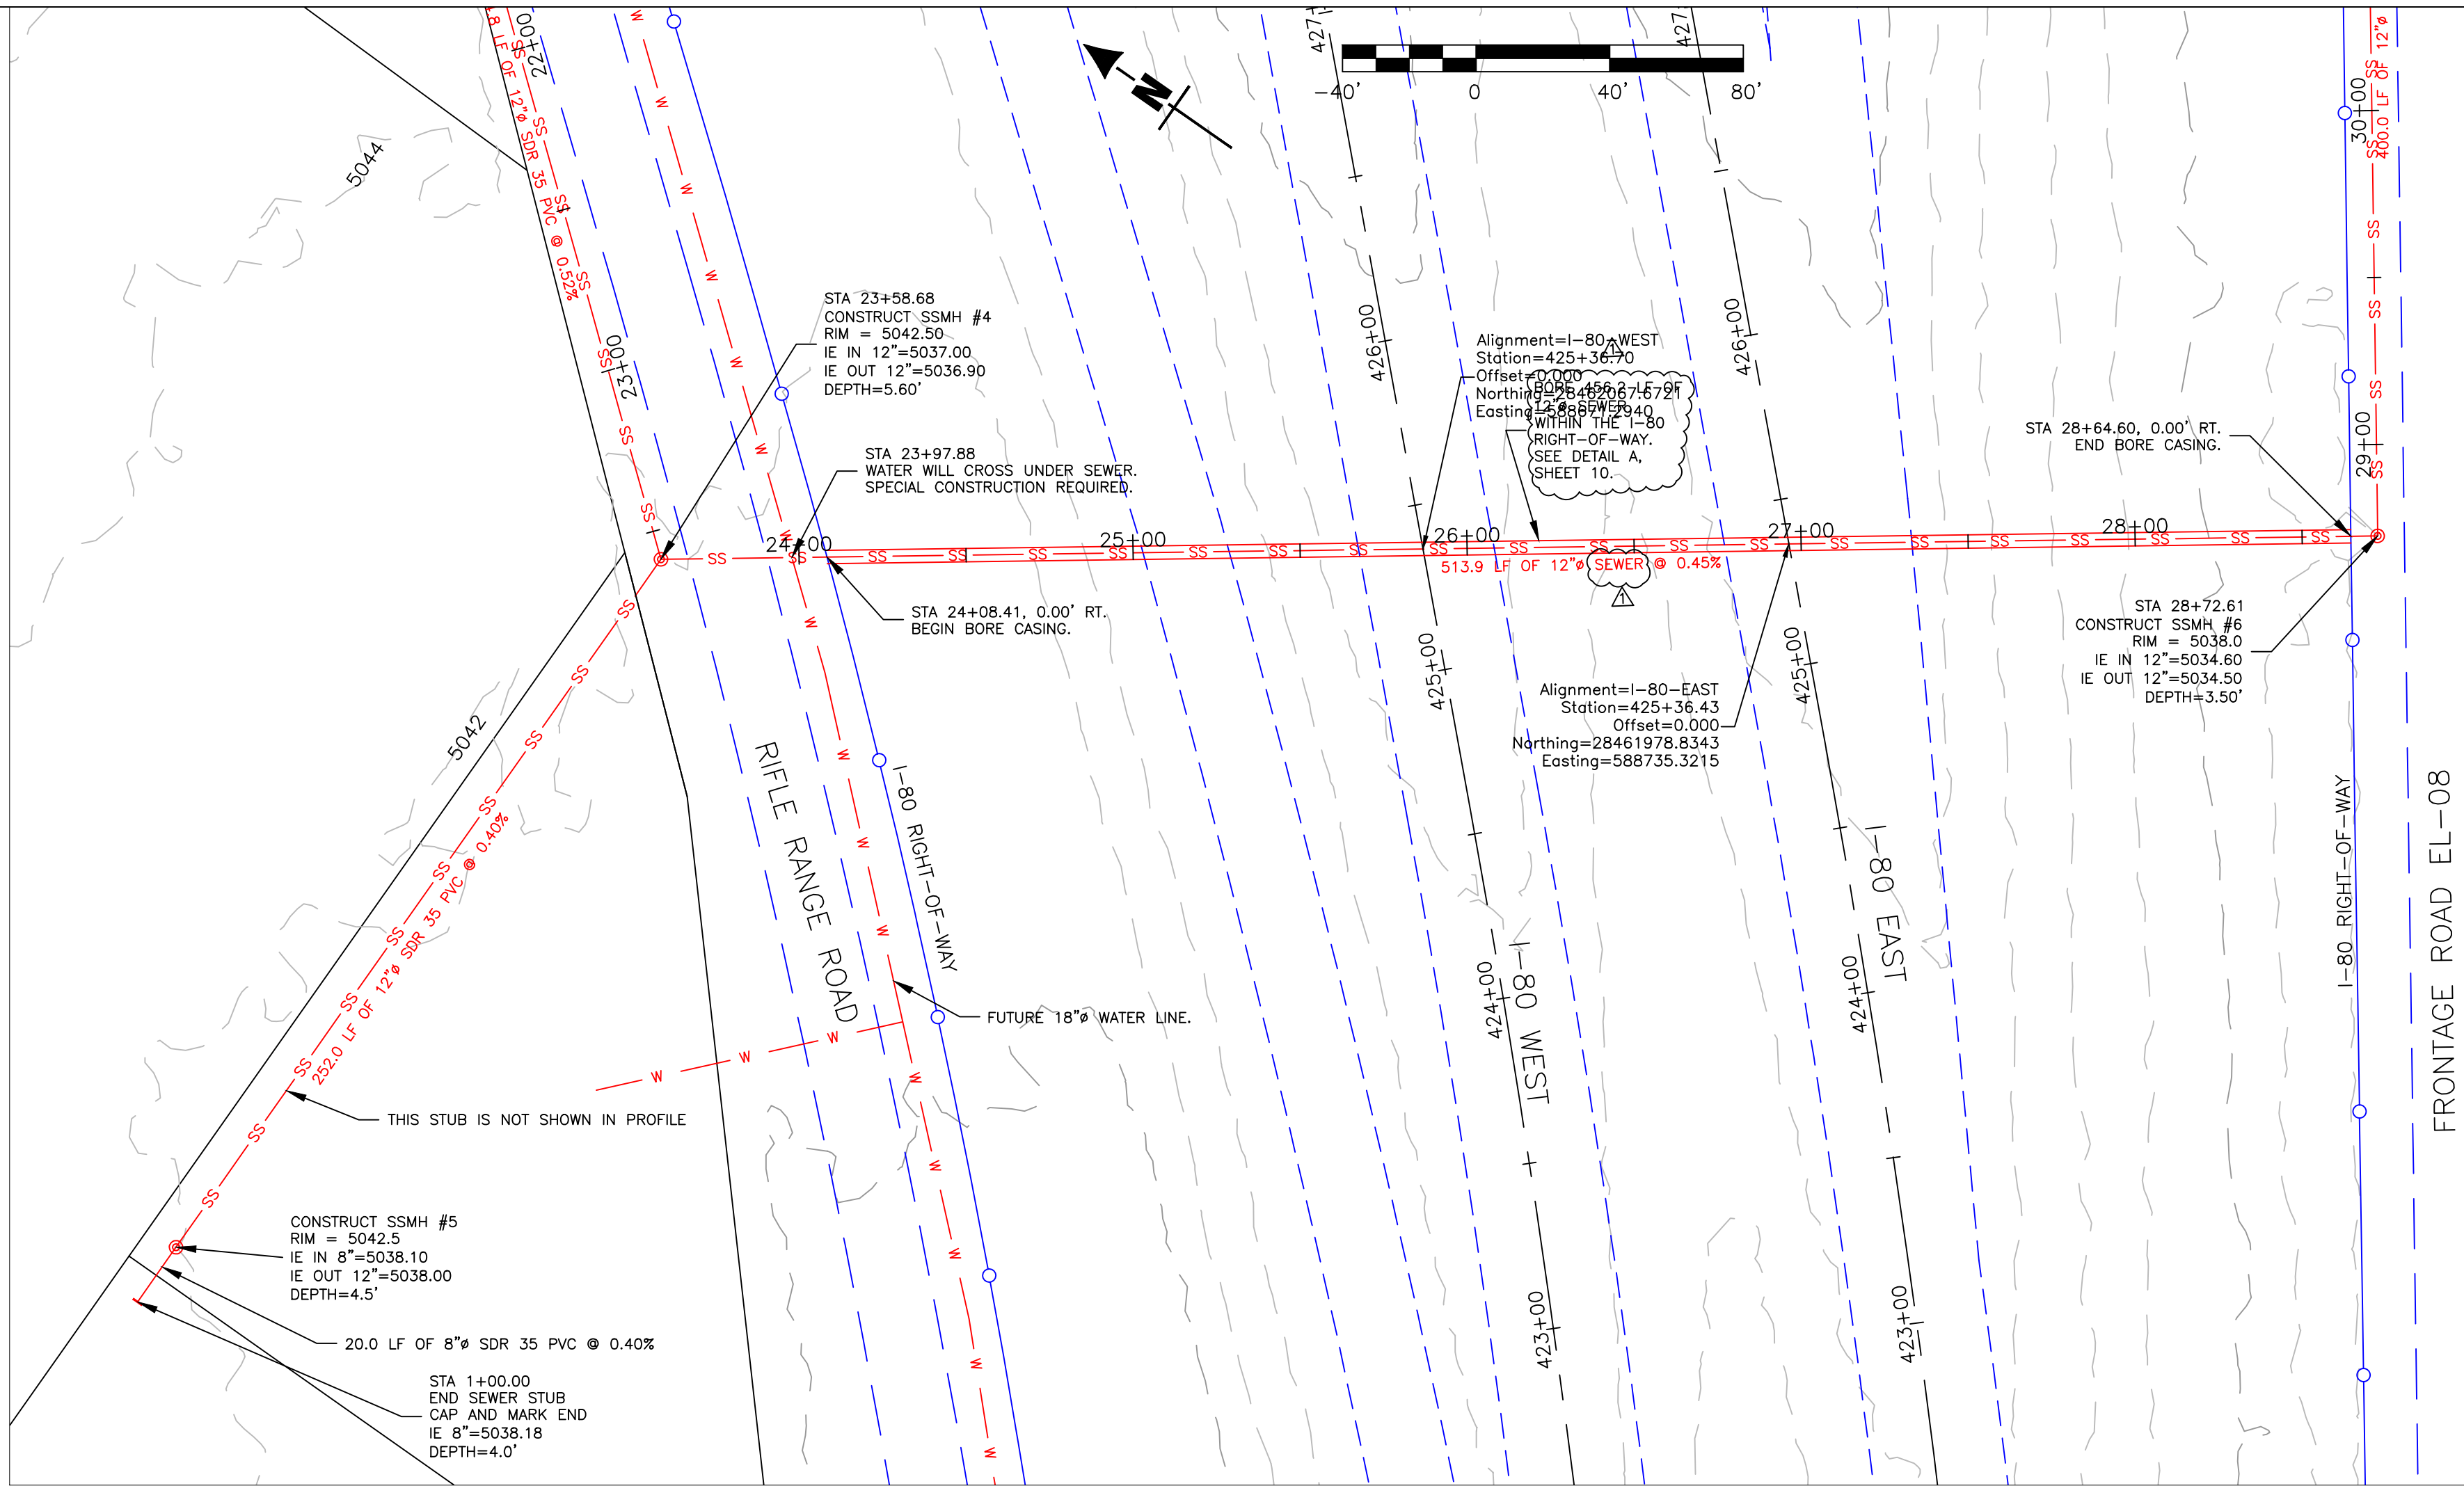

CITY OF ELKO
1751 COLLEGE AVE
ELKO, NEVADA 89801
(775) 777-7210
fax: (775) 777-7219

DESIGN BY: BT
DRAWN BY: ACAD_C3D_2020
CHECKED BY: BT
DATE: 6/22/2022 9:34 AM
JOB NO:

REV	DATE	DESCRIPTION	BY	APVD
1	6/22/22	MINOR CHANGES TO REFLECT ADDENDUM ITEMS	BT	BT


SCALE
HORIZ: 1"=40'
VERT: NONE

EXIT 298 SEWER & WATER DESIGN
PHASE 2
I-80 CROSSING
PLAN AND PROFILE
ELKO
ELKO COUNTY
NEVADA

SHEET
5 OF 10


U:\Streets\P and H Drive\PandH-Drive-6.dwg

MATCH LINE 33+00
SEE SHEET 5

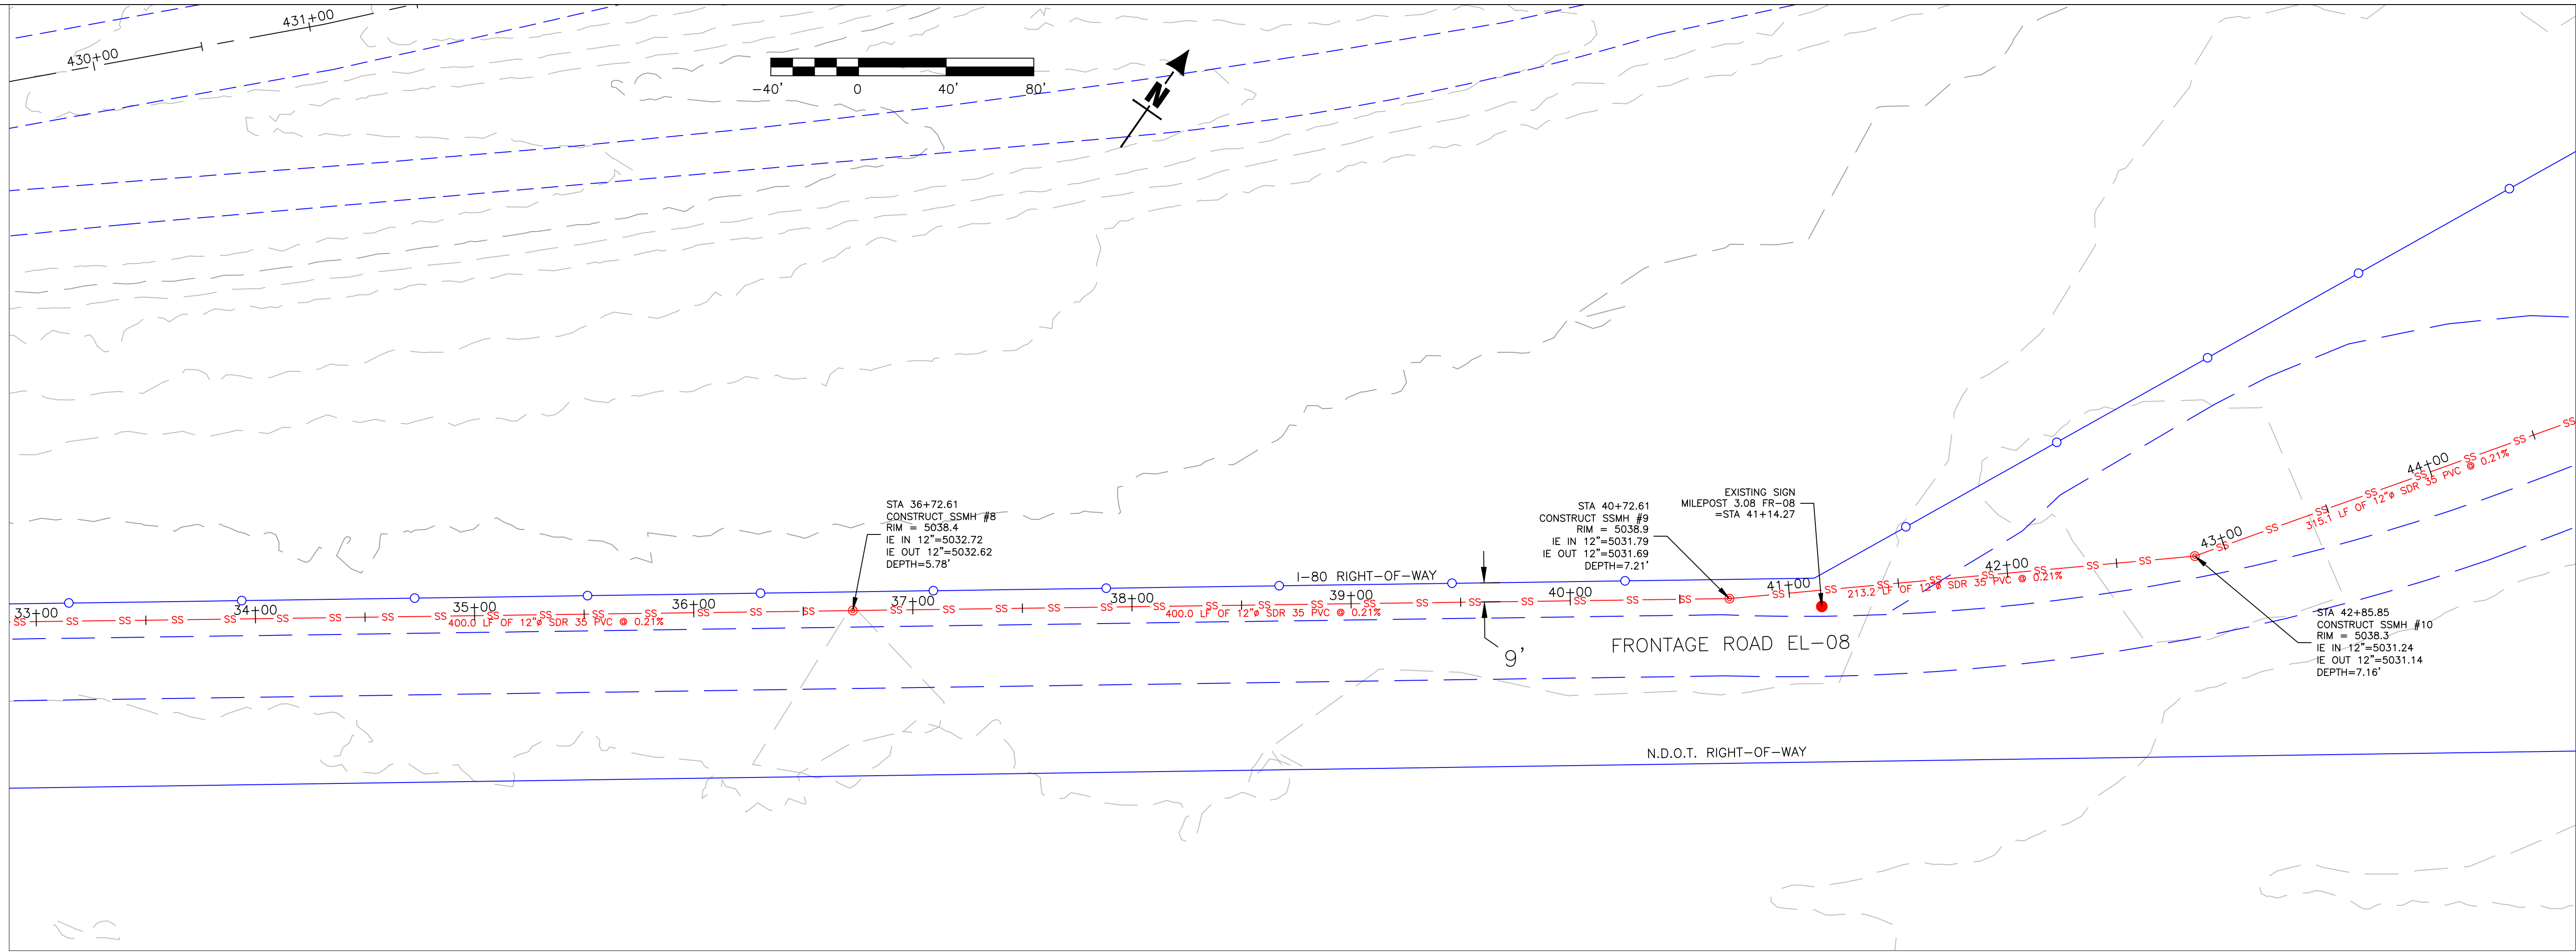

MATCH LINE 44+50
SEE SHEET 7

MATCH LINE 33+00
SEE SHEET 5

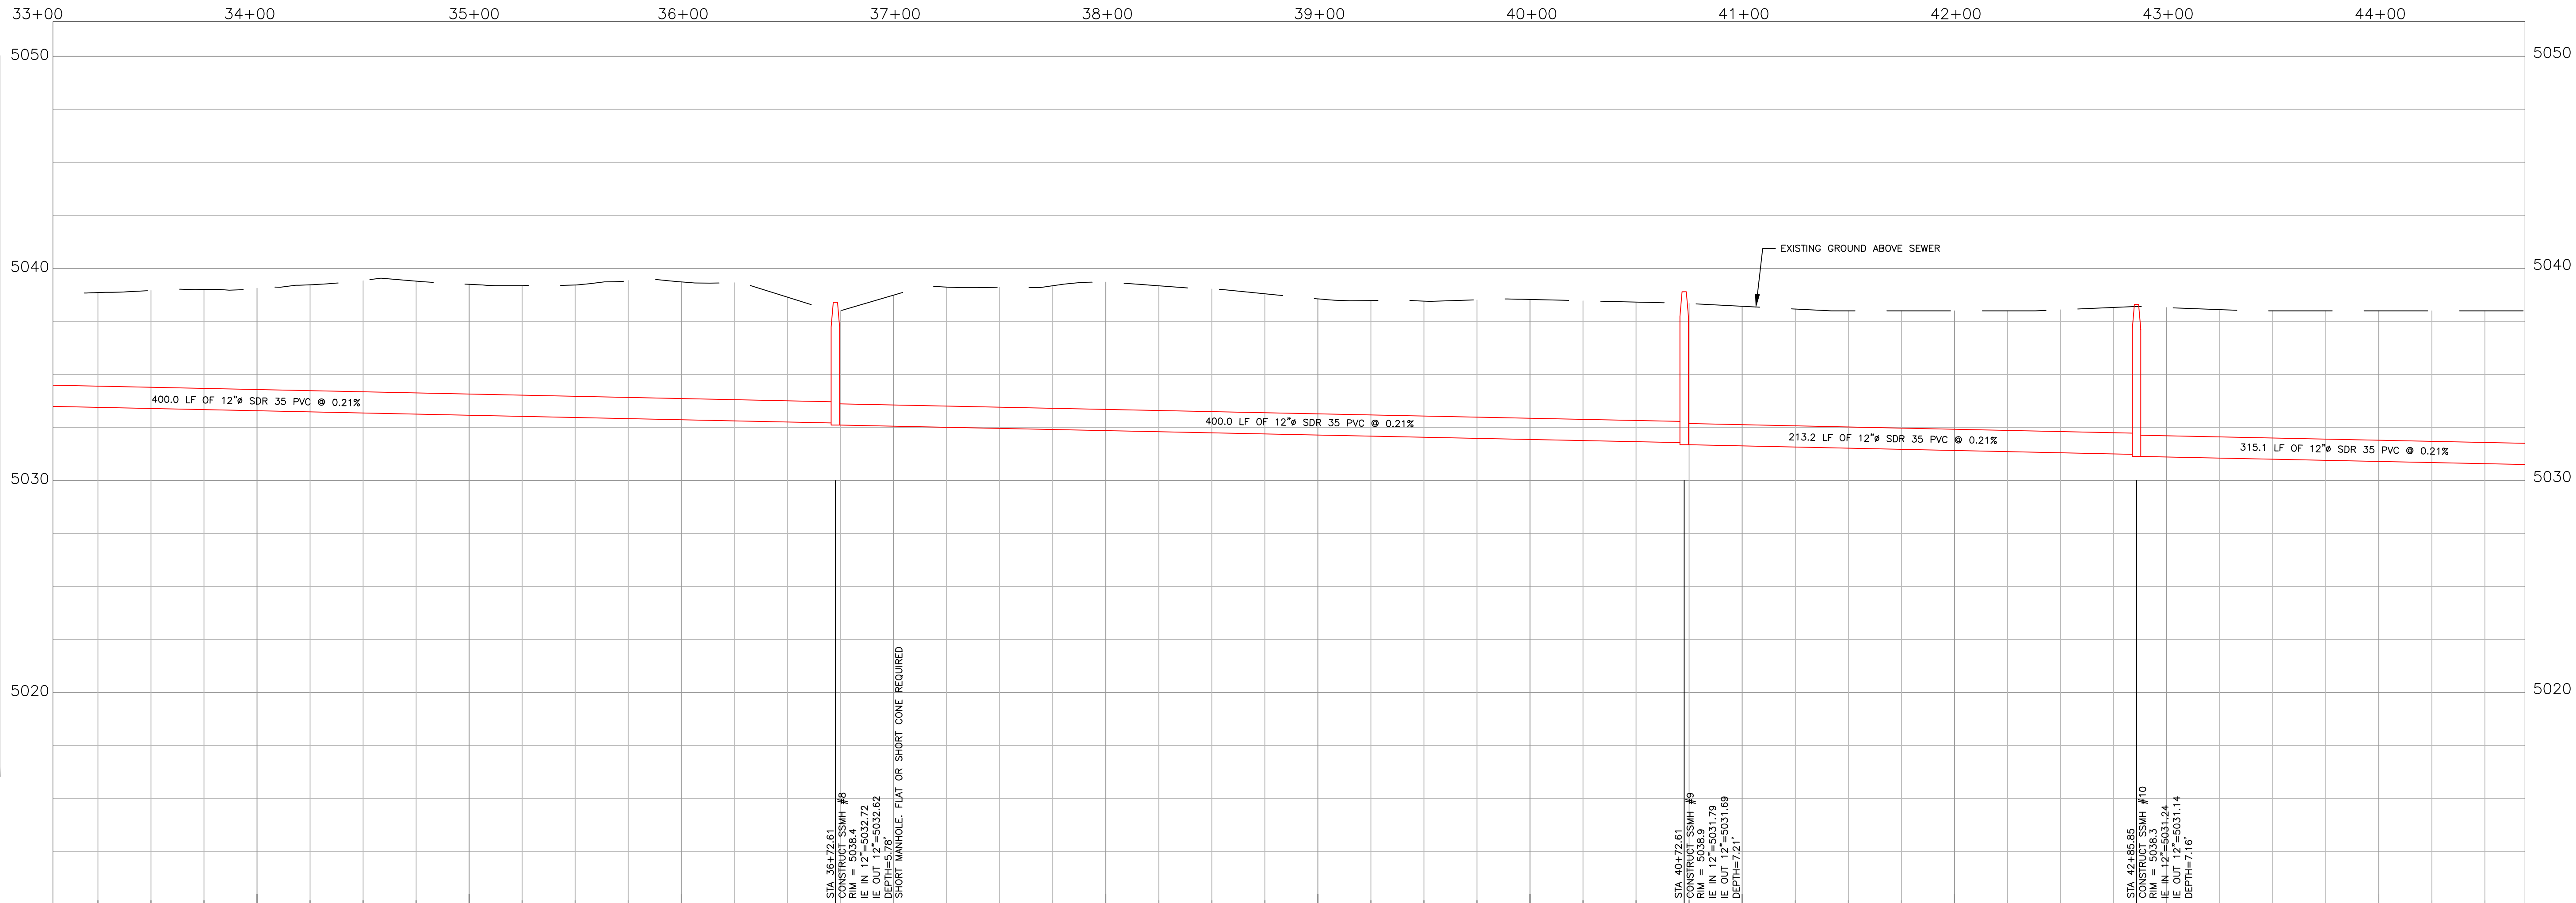

MATCH LINE 44+50
SEE SHEET 7

ELKO COUNTY

ENGINEER

ROBERT THIBAUT

Exp. 06/30/22

CIVIL

Job No. 20723

ELKO

1751 COLLEGE AVE

ELKO, NEVADA 89801

(775) 777-7210

fax: (775) 777-7219

DESIGN BY: BT

DRAWN BY: ACAD_C3D_2020

CHECKED BY: BT

DATE: 6/22/2022 9:55 AM

JOB NO:

REV	DATE	DESCRIPTION	BY	APVD
1	6/22/22	MINOR CHANGES TO REFLECT ADDENDUM ITEMS	BT	BT

SCALE

HORIZ: 1"=40'

VERT: NONE

EXIT 298 SEWER & WATER DESIGN

PHASE 2

FRONTAGE ROAD

PLAN AND PROFILE

ELKO

ELKO COUNTY


NEVADA

SHEET

6 OF 10


U:\Streets\p and H Drive\PendH-Drive-6.dwg

MATCH LINE 44+50
SEE SHEET 6

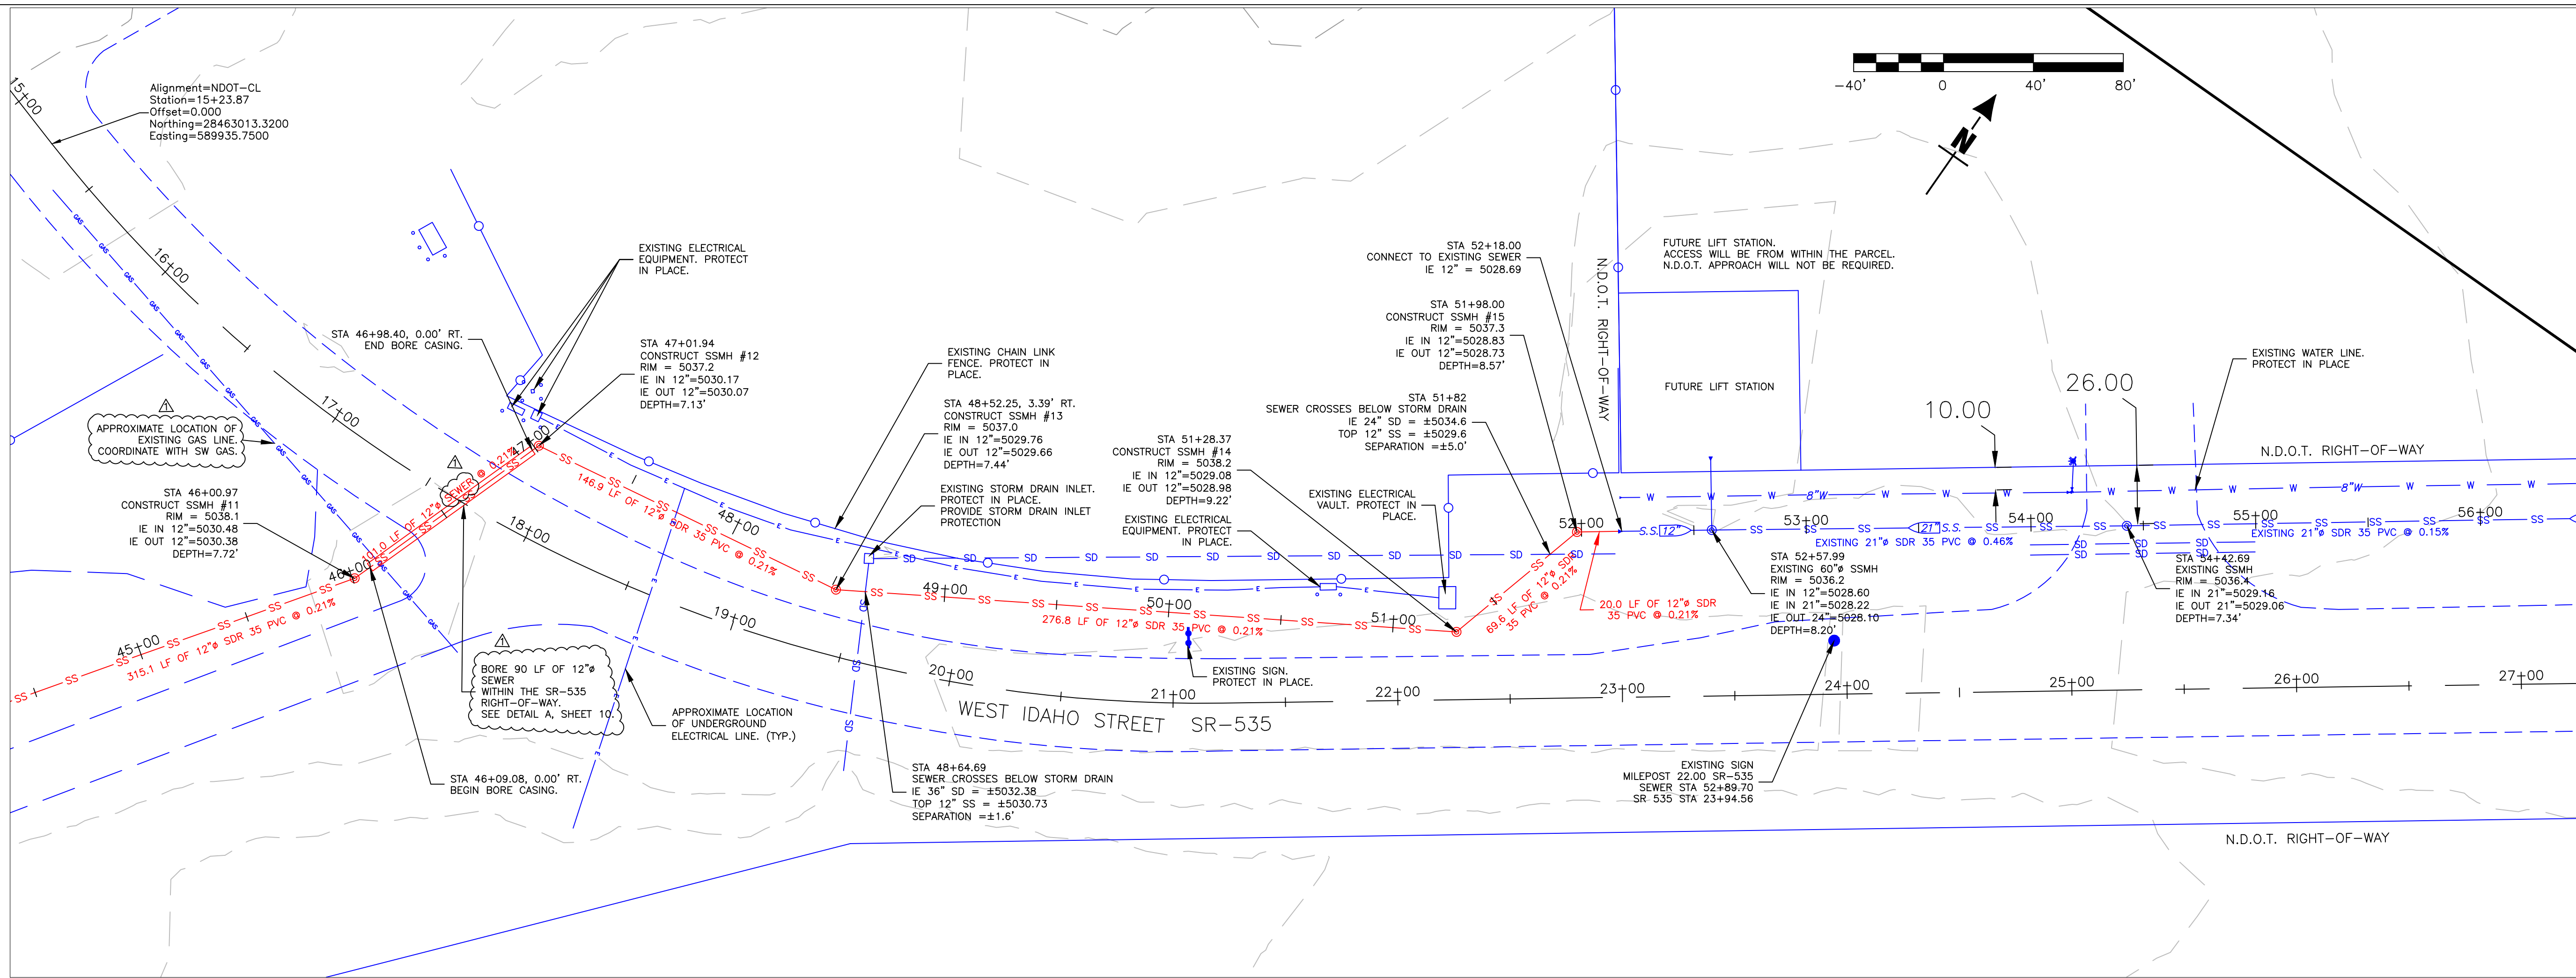

MATCH LINE 56+00
SEE SHEET 8

MATCH LINE 44+50
SEE SHEET 6

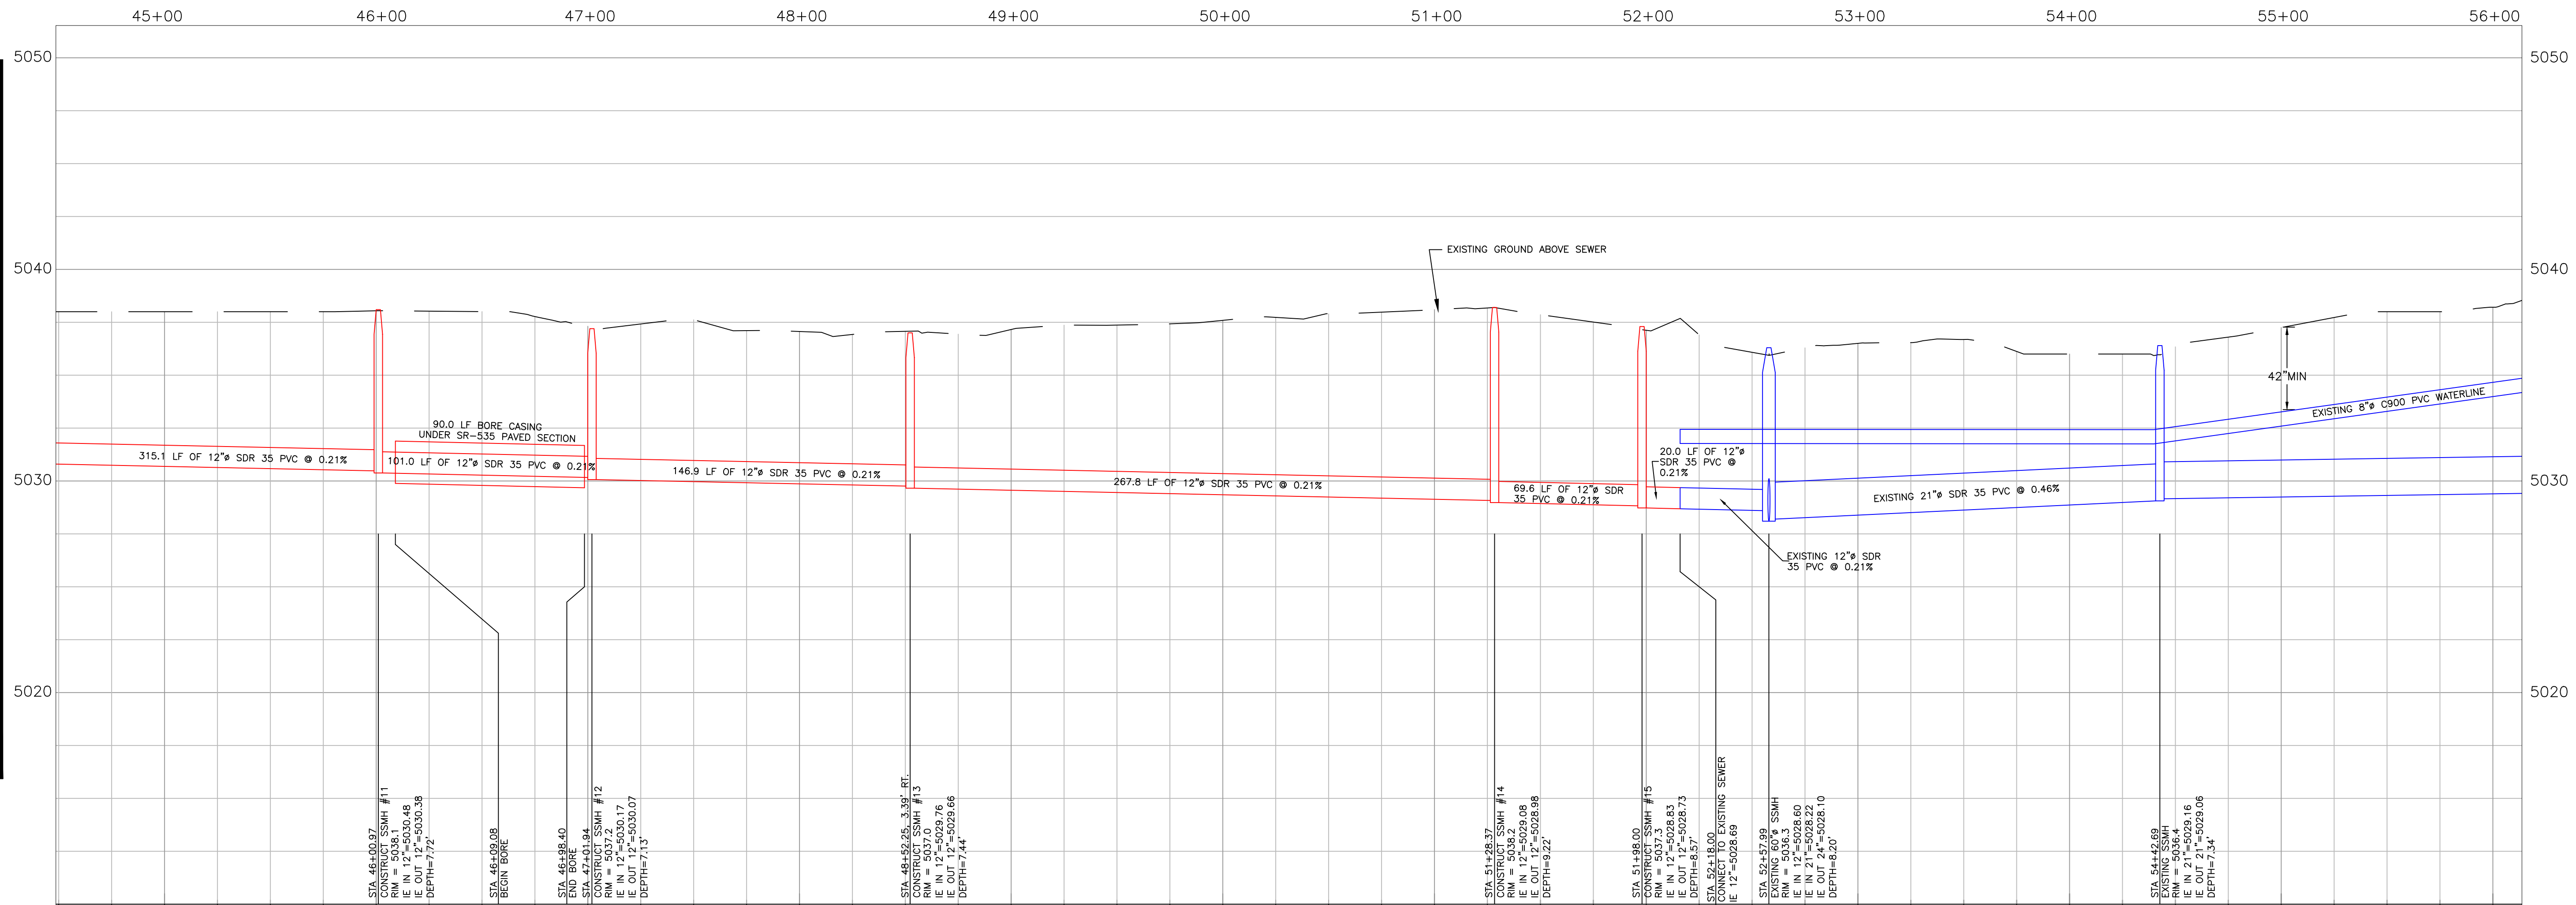

MATCH LINE 56+00
SEE SHEET 8

ENGINEER
ROBERT
THIBAUT
Exp. 06/30/22
CIVIL
NOVEMBER 30, 2017

CITY OF ELKO
1751 COLLEGE AVE
ELKO, NEVADA 89801
(775) 777-7210
fax: (775) 777-7219

DESIGN BY:	BT
DRAWN BY:	ACAD, CSD, 2015
CHECKED BY:	BT
DATE:	6/22/2022 9:36 AM
JOB NO.:	

REV	DATE	DESCRIPTION	BY	APVD
1	6/22/22	MINOR CHANGES TO REFLECT ADDENDUM ITEMS	BT	BT


SCALE
HORIZ: 1"=40'
VERT: NONE

EXIT 298 SEWER & SEWER DESIGN
PHASE 2
WEST IDAHO STREET
PLAN AND PROFILE
ELKO COUNTY NEVADA
ELKO


SHEET
7 OF 10

LA Streets & P and H Drive Penetration Drive - 6.dwg

MATCH LINE 56+00
SEE SHEET 7

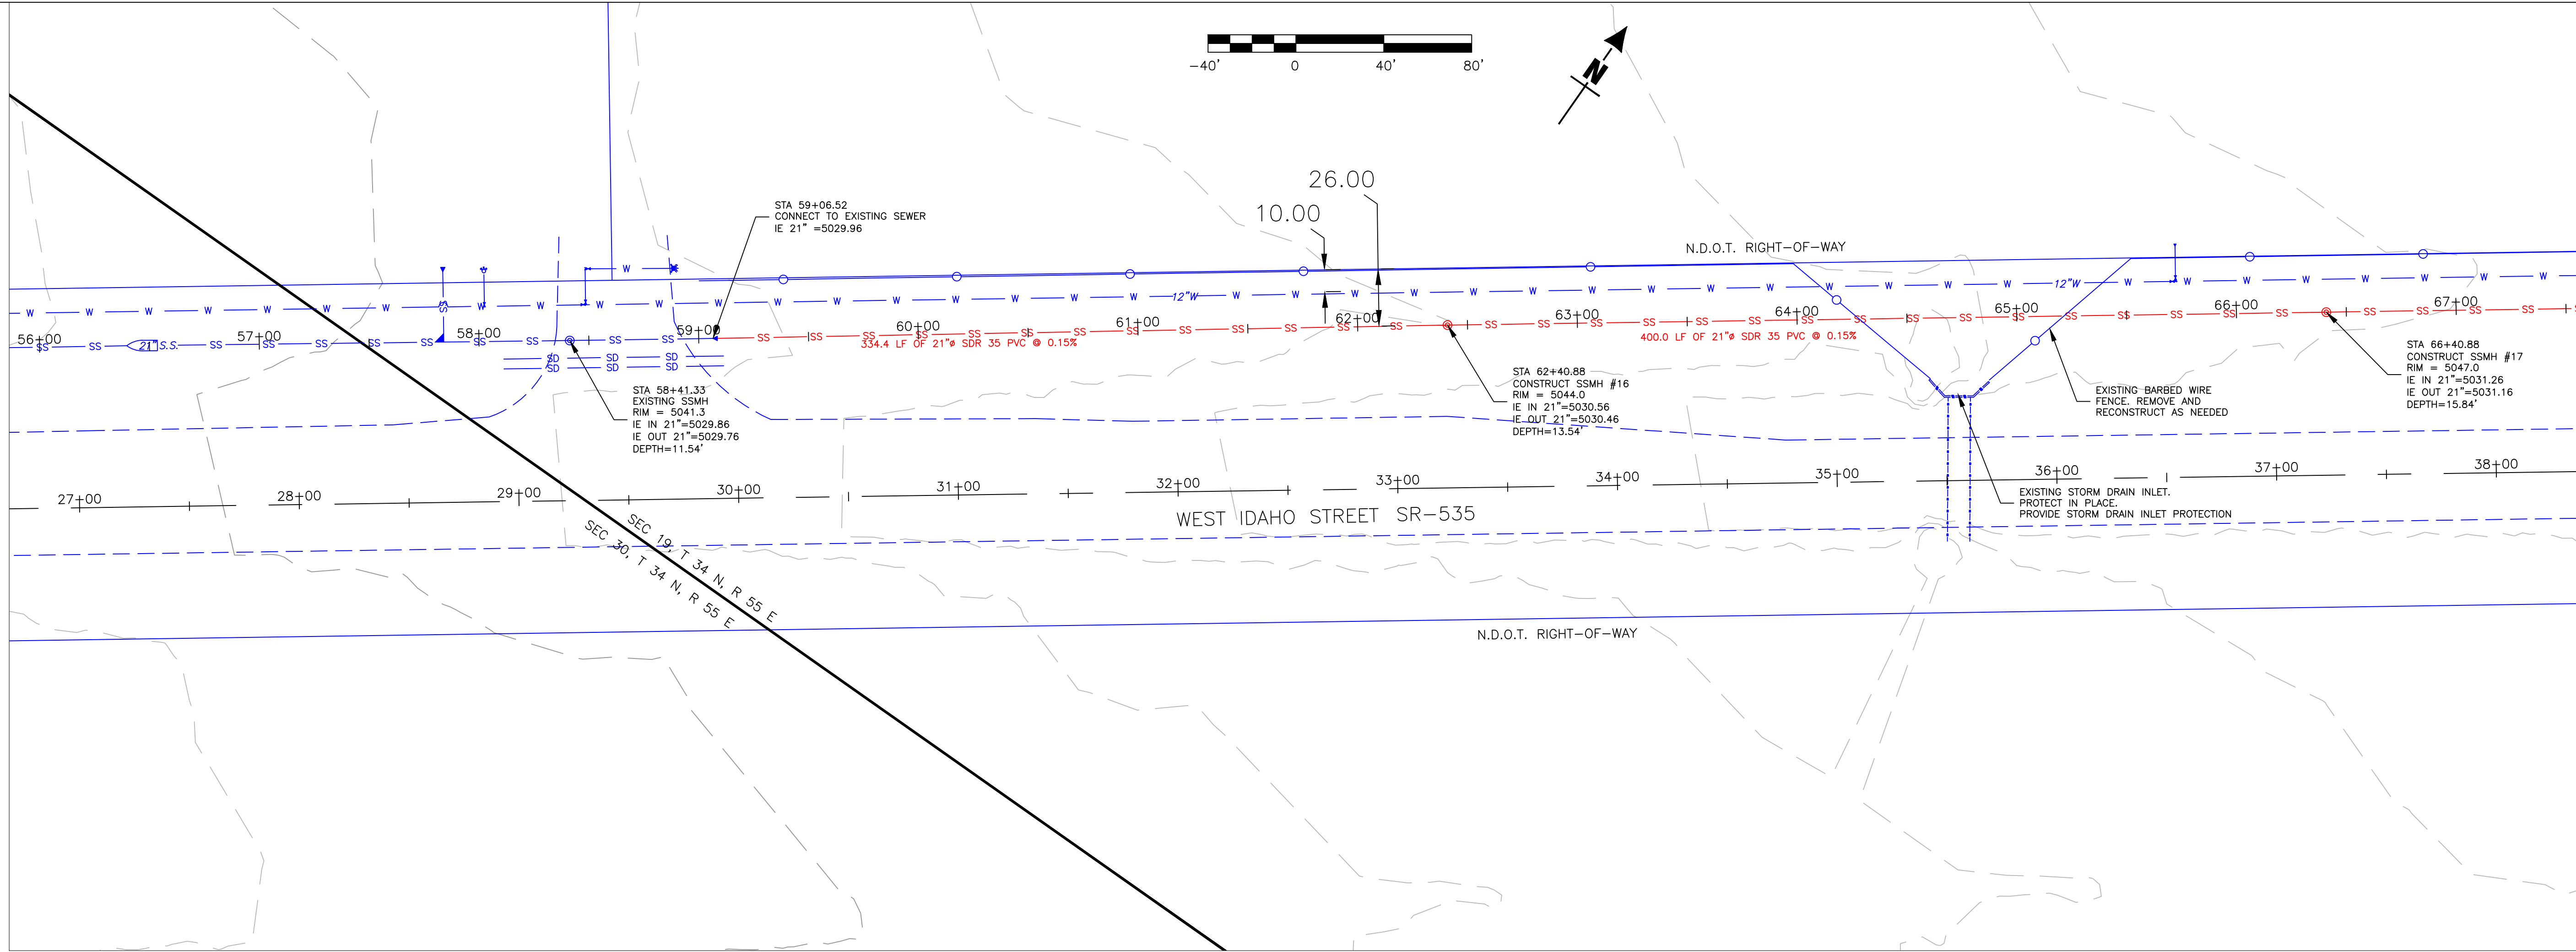

MATCH LINE 56+00
SEE SHEET 7

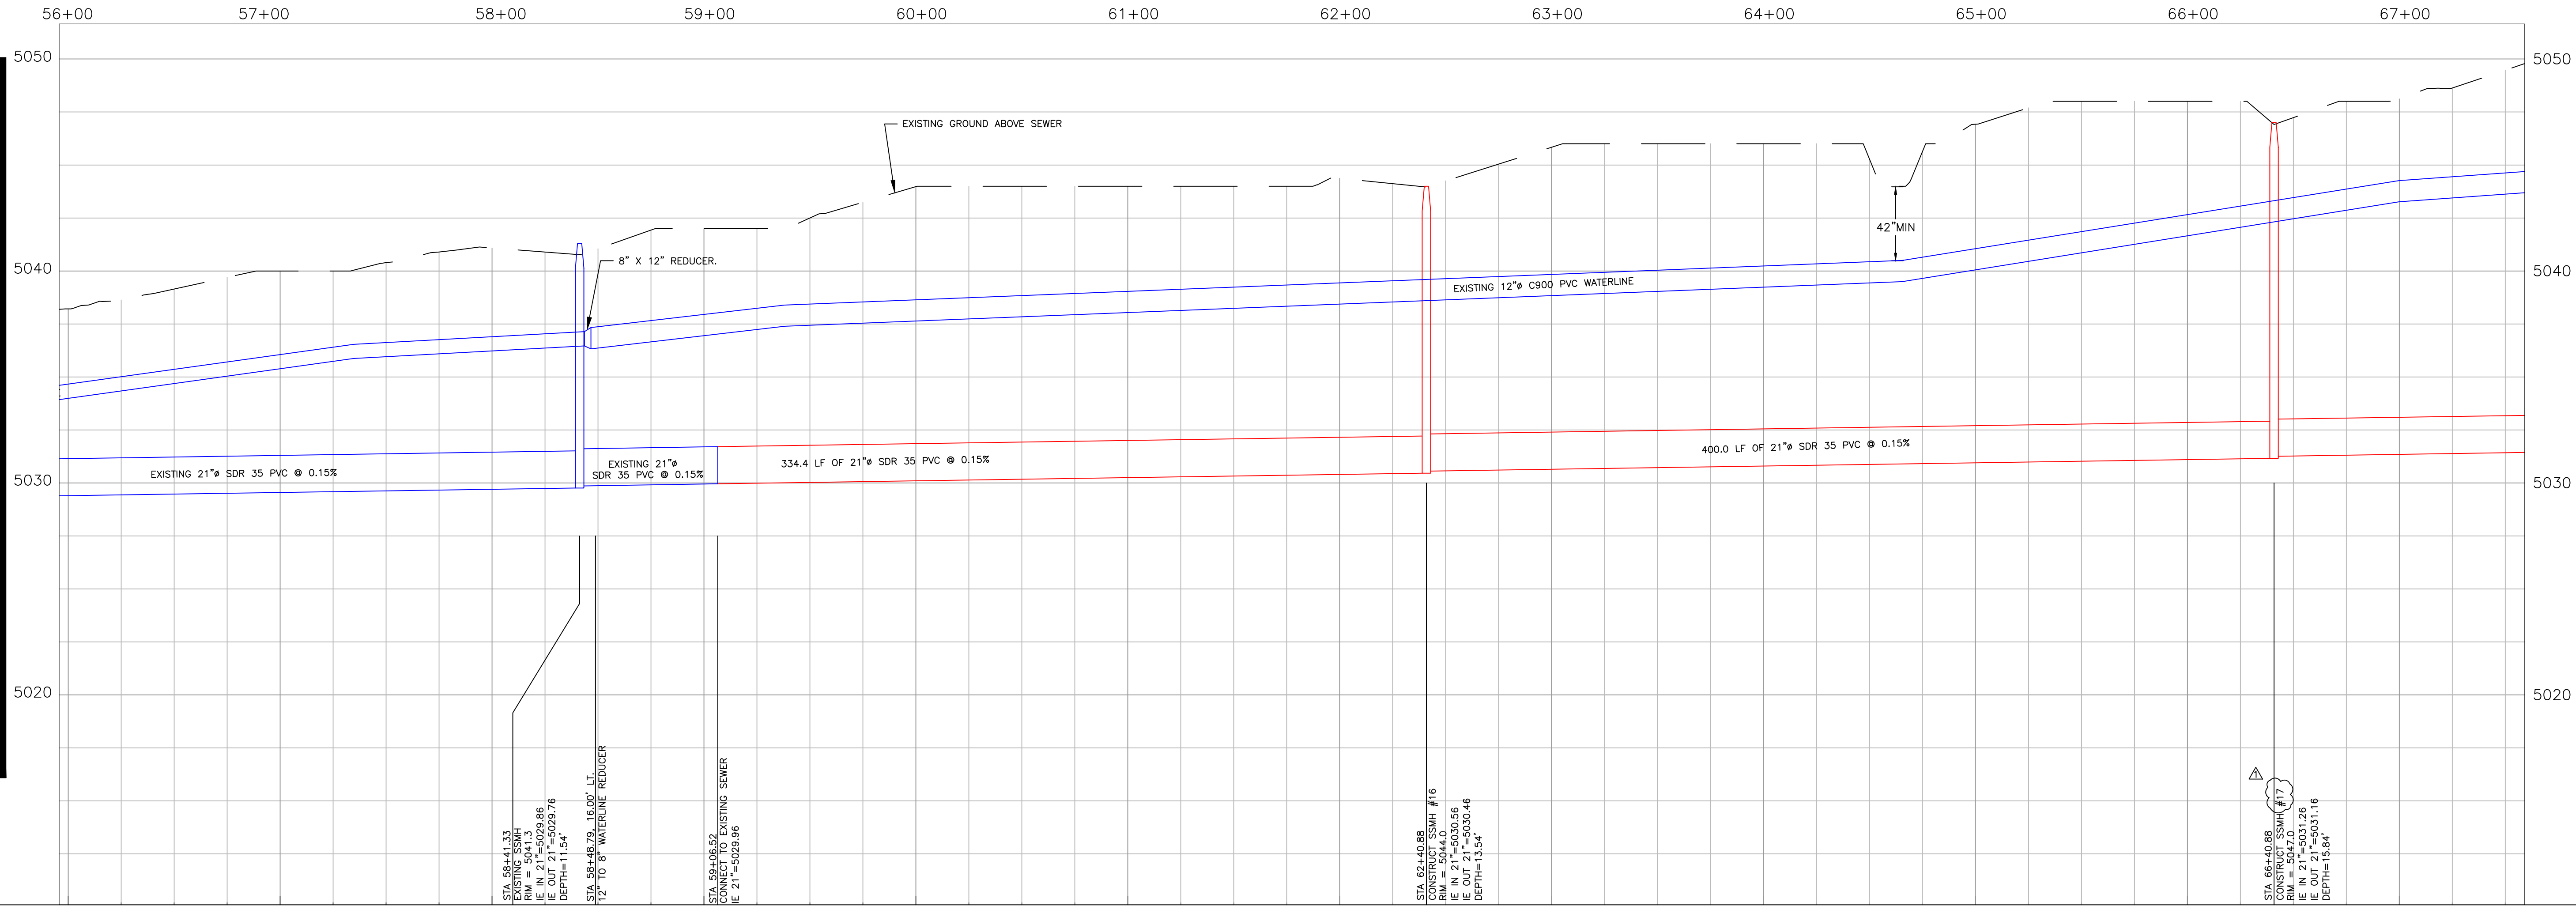

MATCH LINE 67+50
SEE SHEET 9

MATCH LINE 67+50
SEE SHEET 9

ENGINEER

ROBERT

THIBAUT

Exp. 06/30/22

CIVIL

Professional No. 20723

ELKO

1751 COLLEGE AVE

ELKO, NEVADA 89801

(775) 777-7210

fax: (775) 777-7219

DESIGN BY: BT

DRAWN BY: ACAD_C3D_2020

CHECKED BY: BT

DATE: 6/22/2022 9:36 AM

JOB NO:

REV	DATE	DESCRIPTION	BY	APVD
1	6/22/22	MINOR CHANGES TO REFLECT ADDENDUM ITEMS	BT	BT

SCALE

HORIZ: 1"=40'

VERT: NONE

EXIT 298 SEWER & WATER DESIGN

PHASE 2

WEST IDAHO STREET

PLAN AND PROFILE

ELKO


ELKO COUNTY

NEVADA

SHEET

8 OF 10

U:\Sheets\6 and H Drive\Paradise-Drive-6.dwg

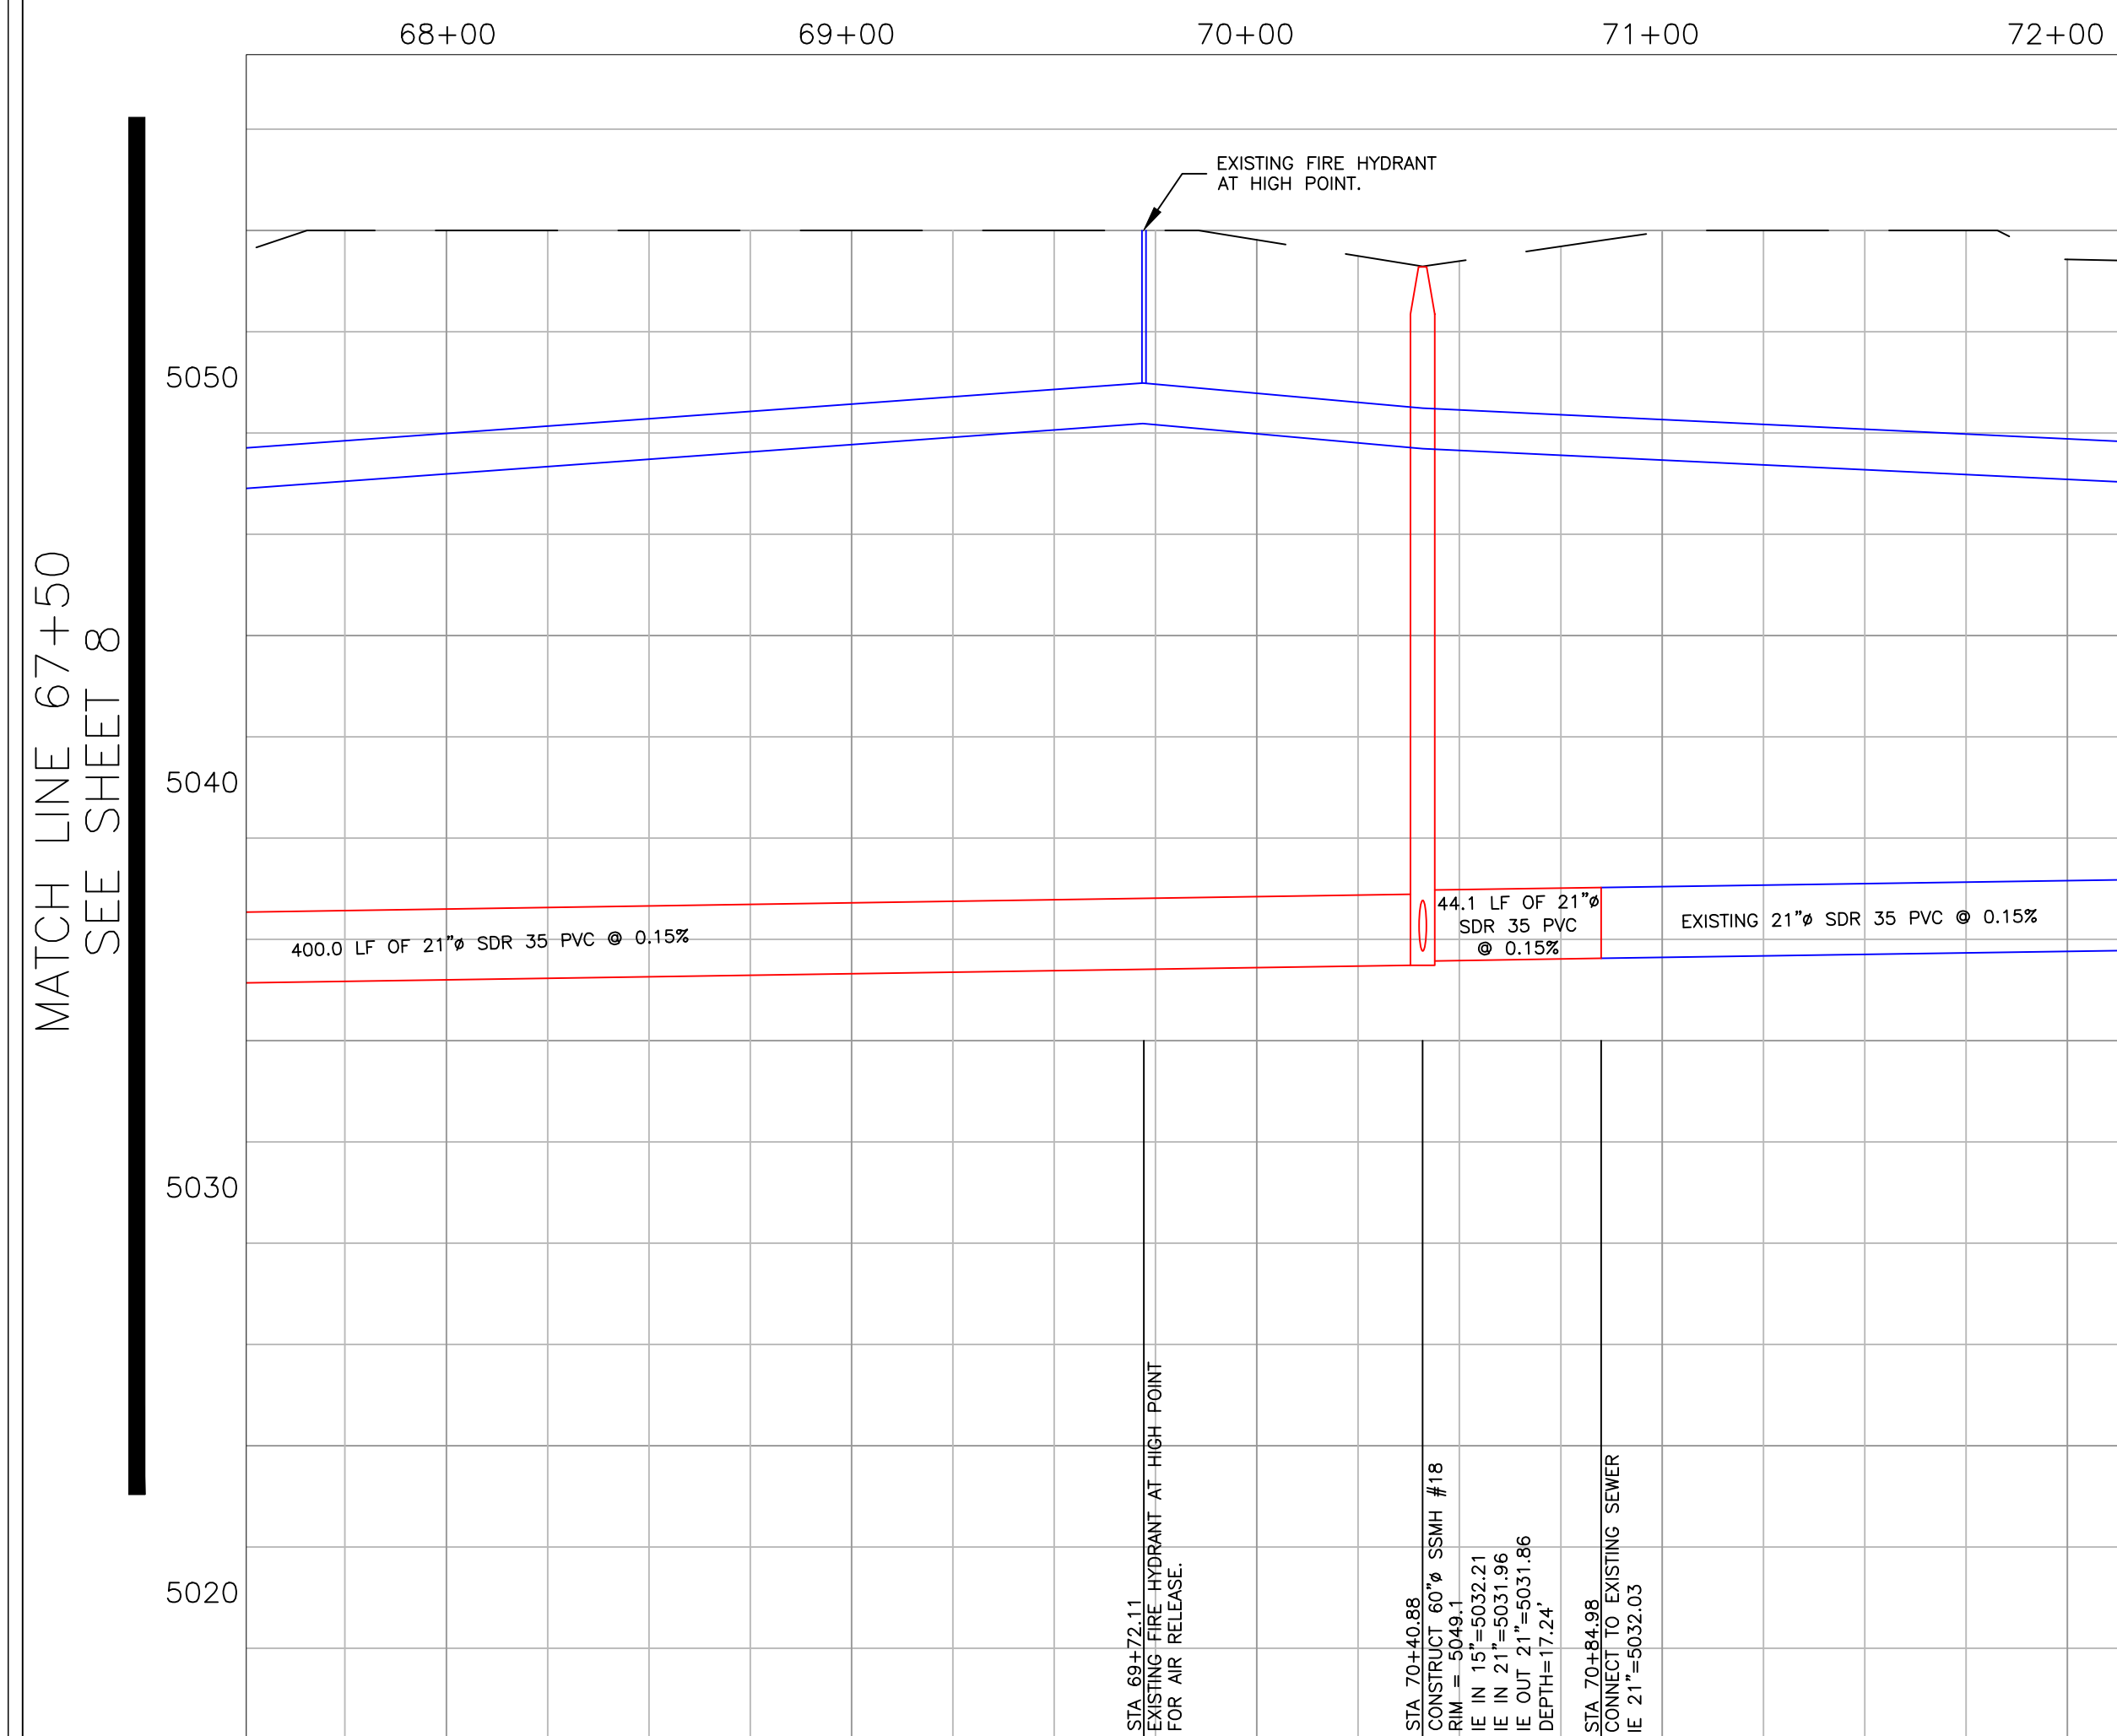



A

NOTES:

- ## TRENCH EXCAVATION AND BACKFILL

NOT TO SCALE

B



C



- ## TYPE 1 MANHOLE

D



- ## CONCRETE COLLAR

E



HORIZ: 1"=300'
VERT: NONE

ADDITIONAL CITY OF ELKO DETAILS CAN BE FOUND AT:

https://www.elkocity.com/departments/engineering_department/standard_details/index.php

EXIT 298 SEWER & WATER DESIGN

PHASE 2
DETAIL SHEET

NIETZSCHE

FELIX COUNTY

FIKO

SHEET

10 OF 10