

Village of Hinsdale
19 E. Chicago Avenue
Hinsdale, IL 60521-3489
(630)789-7000

Village Website: www.villageofhinsdale.org

PUBLIC SERVICES UTILITY PERMIT APPLICATION - Permit Fee of \$100.00

Date of Application: 9-21-21 Permit No: ATT - 0014 REV Permit Expiration Date: ~~10/15/21~~ 6/30/22

Utility Company Information:

Company Name: AT&T
Address: 1000 COMMERCE DR
City, State, Zip: OAK BROOK IL 60523
Contact Person: CARL SIRAN
Phone Number: 708-897-7562
Email Address: CS223T@ATT.COM
Cell Number: 708-897-7562
Project/Work Order Number: ATT#A022PBP

Contractor Information:

Company Name: JOSCO
Address: 2551 Division St #102
City, State, Zip: Joliet, IL, 60435
Contact Person: Chris Nurczyk-PM
Phone Number: OFFICE: 815-725-1975
Email Address: joe.w@josco.com
Cell Number: _____

PROJECT LOCATION: Various locations along Chicago Av

Description of work covered under this permit: Bore and place 3" conduit in right of way and in easement for AT&T fiber build. See attached prints
Estimated cost for excavation approx \$9,000

Bore 2,000 LF of 3" Conduit along Chicago Ave.

ADDITIONAL BORE AT 323 W. CHICAGO AVE & 2-28 S. CLAY ST.

Start Date: 9-30-21

Completion Date: ~~10-1-21~~ 6/30/22

Site Plan/Details/Specifications (3 sets) included with application?
Currently registered as a Utility Contractor with the Village of Hinsdale?
Engineer Estimate of Cost included with application?

☒ YES ☐ NO
☒ YES ☐ NO
☒ YES ☐ NO

Type of Utility: ☐ ComEd ☐ Nicor ☐ Comcast ☐ Water ☐ Sewer
☒ Communications: ☒ Fiber Optic ☐ Wireless ☐ Other: _____

Applicant Information:

Print Name: _____

Phone Number: 708-897-7562

Company: AT&T

Email Address: CS223T@ATT.COM

Signature: CARL SIRAN-ATT ENGINEER Digitally signed by CARL SIRAN-ATT ENGINEER
Date: 2021.09.21 12:52:28 -0500


Date: _____

ALL CONSTRUCTION SHALL BE DONE IN ACCORDANCE WITH THE LATEST EDITION IN EFFECT ON THE DATE OF PERMIT APPLICATION OF THE FOLLOWING: STANDARD SPECIFICATIONS FOR ROAD AND BRIDGE CONSTRUCTION & SUPPLEMENTAL SPECIFICATIONS AND RECURRING SPECIAL PROVISIONS BY THE ILLINOIS DEPARTMENT OF TRANSPORTATION, ILLINOIS MANUAL ON UNIFORM TRAFFIC CONTROL DEVICES FOR STREETS AND HIGHWAYS, STANDARD SPECIFICATIONS FOR WATER AND SEWER MAIN CONSTRUCTION IN ILLINOIS, AND THE VILLAGE OF HINSDALE SUBDIVISION ORDINANCES (Ord. 02007-73, 11-6-2007) AND ENGINEERING STANDARDS.

Village Use Only



Permit Approved: ☒ YES ☐ NO

Conditions for Approval/Reasons for Denial: RESTORE ALL DISTURBED AREAS WITHIN 14 DAYS OF COMPLETION. NOTIFY RESIDENT 48 HOURS PRIOR TO STREET.

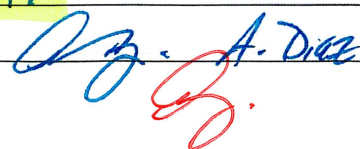Approved By: 

Date: ~~9/22/21~~ 3/17/22

ATT PERMIT ADDENDUM #2

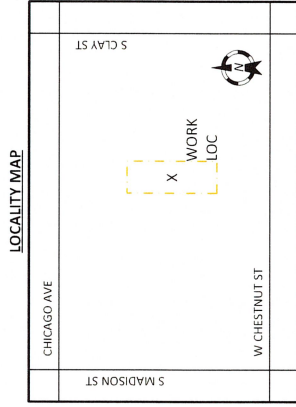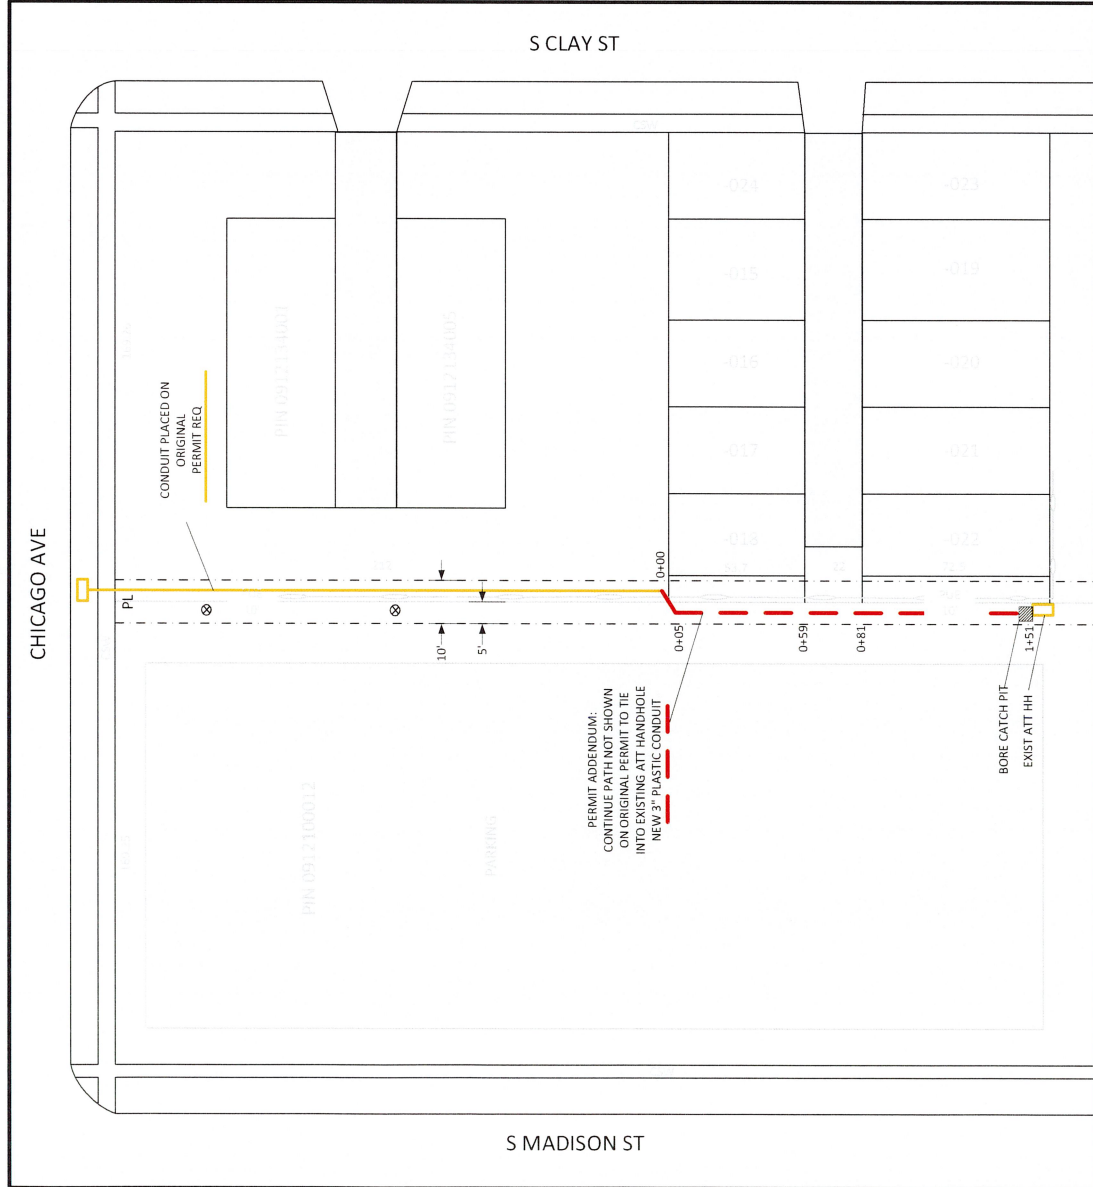


ATT PERMIT ADDENDUM #2

ATT TO CONTINUE BORE AND
PLACE 1-3" PLASTIC CONDUIT
151' ALONG SAME PATH ON
PREVIOUS PERMIT TO TIE INTO
EXISTING ATT HANDHOLE

ALL RESTORATION AND
REQUIREMENTS OUTLINED IN
PREVIOUS PERMIT WILL FOLLOW
THIS ADDENDUM

All Digging Restoration to be done
by AT&T to like or better condition.
Follow all requirements as outlined
on original permit

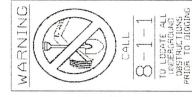

Project # A022PBP **State:** IL
County: DUPAGE
Township: DOWNERS GROVE NORTH
Municipality: HINSDALE
Quarter Section: 1 & 12


[illegible]

**DUE TO LIMITED OVERHEAD CABLE PLACEMENT
OPTIONS AND COMED CLEARANCES ATT HAS
DECIDED TO PURSUE A BURIED OPTION FOR ATT
FIBER CABLE PLACEMENT**

LOC1-WORK BEGINS IN ROW GRASS AREA AT
MH188B 0+00 EAST 5' THEN TURNS NORTH 101'
TO 1+06 PLACING 1-2" PLASTIC CONDUIT.



PLACED VIA DIRECTIONAL BORE. FLAGGING MAY BE REQUIRED ON CHICAGO AVE WB LANE DURING BORE. PROPER DOT SIGNAGE AND FLAGGERS TO BE USED.

LOC2- EXISTING CONDUIT WILL BE ACCESSED AND REDIRECTED UP POLE LOCATION IN SOUTH ROW OF CHICAGO AVE. THIS PROVIDES A PATH WITHOUT HAVING TO OPEN CUT ROADWAY

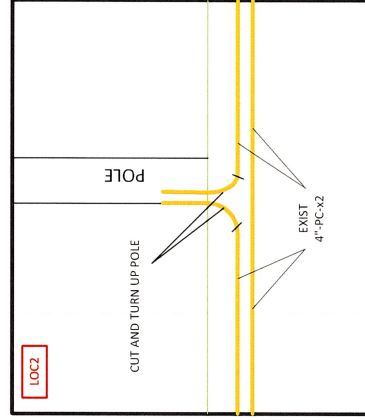

Quarter Section: 1 & 12

PROPOSED WORK AREA

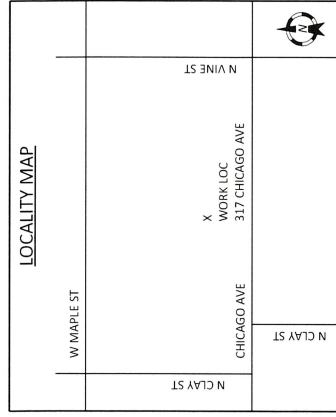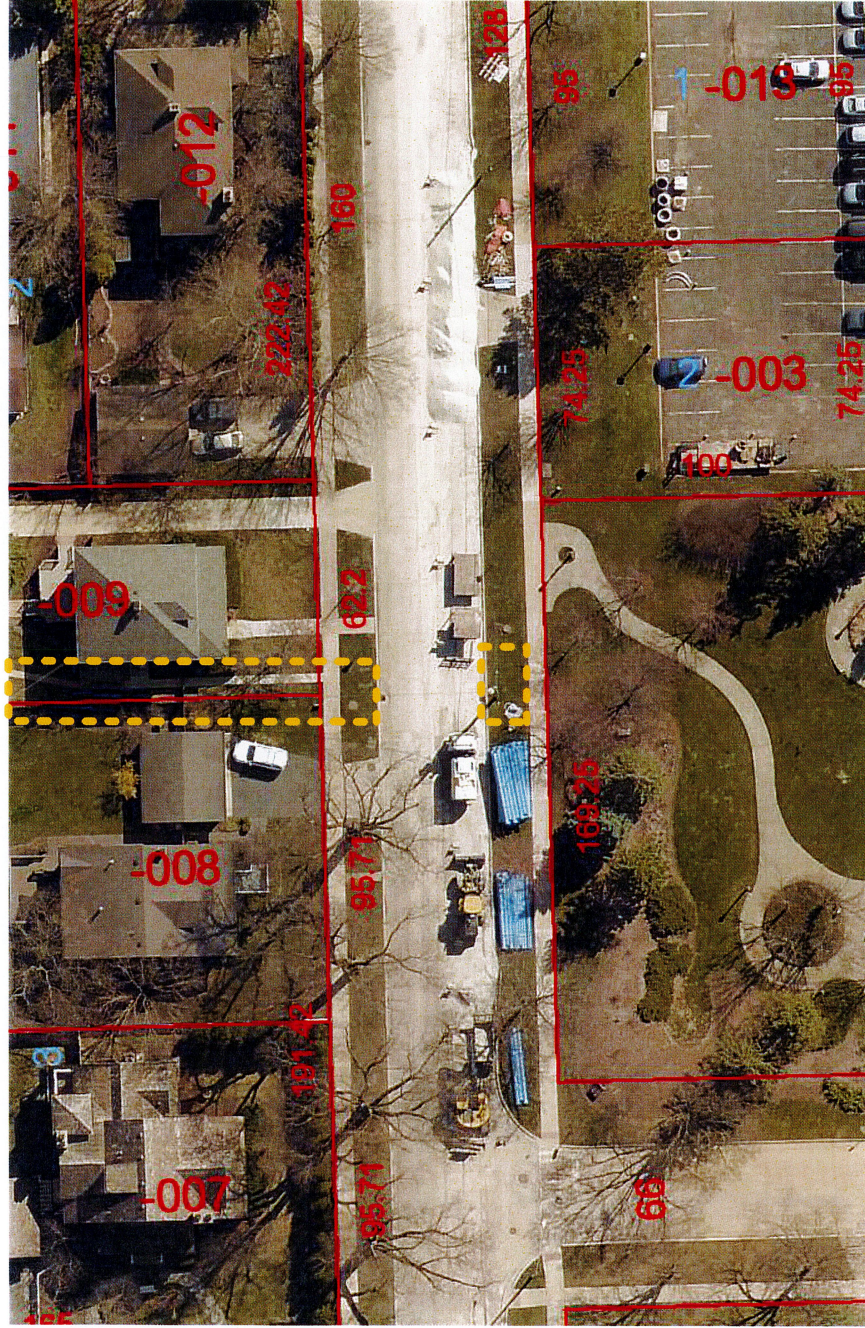

DUE TO LIMITED OVERHEAD CABLE PLACEMENT OPTIONS AND COMED CLEARANCES ATT HAS DECIDED TO PURSUE A BURIED OPTION FOR ATT FIBER CABLE PLACEMENT

LOC1-WORK BEGINS IN ROW GRASS AREA AT MH188B
0+00 EAST 5' THEN TURNS NORTH 101' TO 1+06 PLACING
1-2" PLASTIC CONDUIT. PLACED VIA DIRECTIONAL BORE.
FLAGGING MAY BE REQUIRED ON CHICAGO AVE WB LANE
DURING BORE. PROPER DOT SIGNAGE AND FLAGGERS TO
BE USED.

LOC2- EXISTING CONDUIT WILL BE ACCESSED AND REDIRECTED UP POLE LOCATION IN SOUTH ROW OF CHICAGO AVE. THIS PROVIDES A PATH WITHOUT HAVING TO OPEN CUT ROADWAY

Project # A022PBP **State:** IL
County: DUPAGE
Township: DOWNERS GROVE NORTH
Municipality: HINSDALE
Quarter Section: 1 & 12



Village of Hinsdale
19 E. Chicago Avenue
Hinsdale, IL 60521-3489
(630)789-7000

Village Website: www.villageofhinsdale.org

PUBLIC SERVICES UTILITY PERMIT APPLICATION - Permit Fee of \$100.00

Date of Application: 9-21-21 Permit No: ATT - 0014 REV Permit Expiration Date: 10/15/21

Utility Company Information:

Company Name: AT&T
Address: 1000 COMMERCE DR
City, State, Zip: OAK BROOK IL 60523
Contact Person: CARL SIRAN
Phone Number: 708-897-7562
Email Address: CS223T@ATT.COM
Cell Number: 708-897-7562
Project/Work Order Number: ATT#A022PBP

Contractor Information:

Company Name: JOSCO
Address: 2551 Division St #102
City, State, Zip: Joliet, IL, 60435
Contact Person: Chris Nurczyk-PM
Phone Number: OFFICE: 815-725-1975
Email Address: joe.w@josco.com
Cell Number: _____

PROJECT LOCATION: Various locations along Chicago Av

Description of work covered under this permit: Bore and place 3" conduit in right of way and in easement for AT&T fiber build. See attached prints
Estimated cost for excavation approx \$9,000

Bore 2,000 LF of 3" Conduit along Chicago Ave.

Start Date: 9-30-21

Completion Date: 10-1-21

Site Plan/Details/Specifications (3 sets) included with application?
Currently registered as a Utility Contractor with the Village of Hinsdale?
Engineer Estimate of Cost included with application?

☒ YES ☐ NO
☒ YES ☐ NO
☒ YES ☐ NO

Type of Utility: ☐ ComEd ☐ Nicor ☐ Comcast ☐ Water ☐ Sewer
☒ Communications: ☒ Fiber Optic ☐ Wireless ☐ Other: _____

Applicant Information:

Print Name: _____ Phone Number: 708-897-7562
Company: AT&T Email Address: CS223T@ATT.COM
Signature: CARL SIRAN-ATT ENGINEER Digitally signed by CARL SIRAN-ATT ENGINEER
Date: 2021.09.21 12:52:28 -0500 Date: _____

ALL CONSTRUCTION SHALL BE DONE IN ACCORDANCE WITH THE LATEST EDITION IN EFFECT ON THE DATE OF PERMIT APPLICATION OF THE FOLLOWING: STANDARD SPECIFICATIONS FOR ROAD AND BRIDGE CONSTRUCTION & SUPPLEMENTAL SPECIFICATIONS AND RECURRING SPECIAL PROVISIONS BY THE ILLINOIS DEPARTMENT OF TRANSPORTATION, ILLINOIS MANUAL ON UNIFORM TRAFFIC CONTROL DEVICES FOR STREETS AND HIGHWAYS, STANDARD SPECIFICATIONS FOR WATER AND SEWER MAIN CONSTRUCTION IN ILLINOIS, AND THE VILLAGE OF HINSDALE SUBDIVISION ORDINANCES (Ord. 02007-73, 11-6-2007) AND ENGINEERING STANDARDS.

Village Use Only

Permit Approved: ☒ YES ☐ NO

Conditions for Approval/Reasons for Denial: RESTORE ALL DISTURBED AREAS WITHIN 14 DAYS OF COMPLETION. NOTIFY RESIDENT 48 HOURS PRIOR TO STREET.

Approved By: A. Dice Date: 9/22/21

GENERAL CONSTRUCTION NOTES:

ALL TRENCHED AREA SHALL BE COMPACTED AND RESTORED IN LIFTS. SODDED AREAS WILL BE RESTORED TO EXISTING CONDITIONS OR BETTER OR AS DIRECTED BY THE CITY ENGINEER. EROSION PROTECTION WILL BE REQUIRED DURING APPLICABLE OFF SEASON.

WHEN POSSIBLE, SAW CUTS SHALL BE MADE AT EXISTING JOINT LINES. ALL CONCRETE SHALL BE KEVED INTO EXISTING STRUCTURES. IF MINIMUM DISTANCE FROM JOINT TO SAW CUT LINE CANNOT BE OBTAINED, REMOVE AND REPLACE TO JOINT. ALL BASE OR SUB-BASE SHALL BE COMPACTED PER THE STANDARD SPECIFICATIONS FOR PUBLIC WORKS CONSTRUCTION.



THE FULL PERIMETER OF ANY ASPHALT RESTORATION LIMITS SHALL BE SEALED COMPLETELY AT THE EDGES OF THE CUT WITH LIQUID ASPHALTIC CEMENT IRONED IN WITH A HEATED SMOOTHING IRON OR BY MEANS OF INFRARED TREATMENT TO PREVENT WATER SEEPAGE INTO THE PAVEMENT, UNLESS OTHERWISE DIRECTED BY THE CITY ENGINEER.

ALL PAVEMENT PATCH OPENINGS THAT ARE OPEN TO TRAFFIC SHALL BE IMMEDIATELY SURFACED WITH A TEMPORARY BITUMINOUS PATCH AT LEAST THREE INCHES IN THICKNESS. THIS PATCH THEN MUST BE INSPECTED DAILY AND ADDITIONAL BITUMINOUS PATCH MATERIAL MUST BE PLACED, DAILY IF NECESSARY, TO MAINTAIN THE PATCHED AREA AT THE SAME ELEVATION AS THE ADJACENT UNDISTURBED PAVEMENT FOR A PERIOD OF NOT LESS THAN 30 DAYS. AFTER 30 DAYS, PERMANENT REPLACEMENT IN KIND SHALL BE MADE TO THE BASE COURSE AND PAVEMENT SURFACE.

WORK SUMMARY

1. BORE FROM POLE TO BORE PIT AND PLACE (1) 4"PC.
2. PLACE 3 BOREPITS

LOCALITY MAP

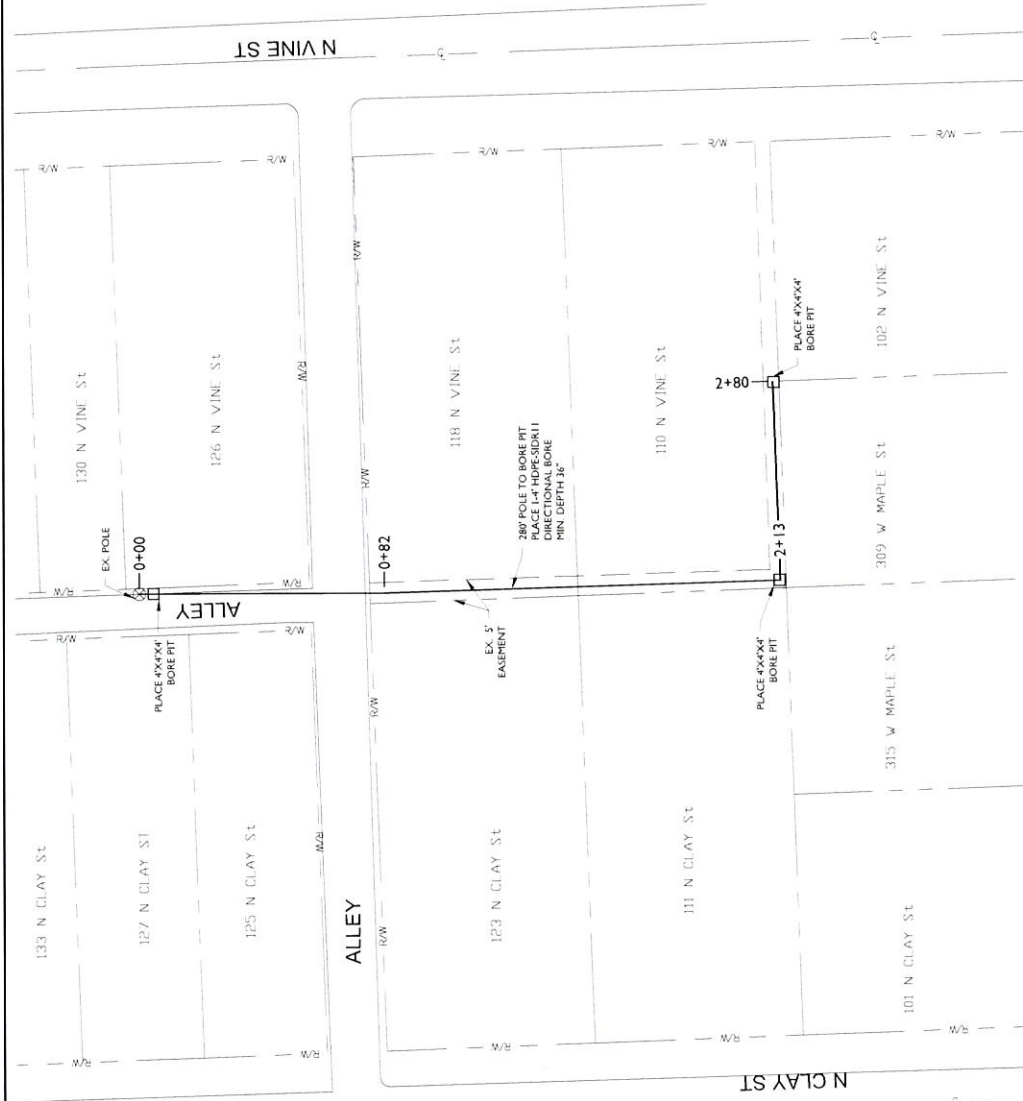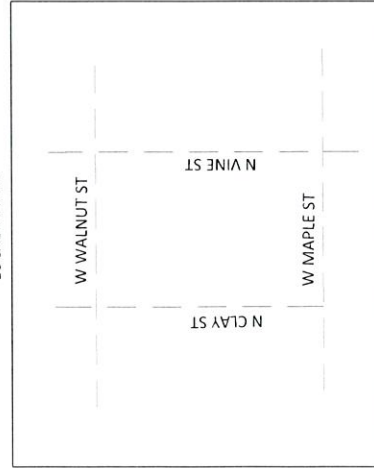

24x36 SCALE 1" = 40'-0"
11x17 SCALE 1" = 80'-0"



AT&T ENGINEER CONTACT INFO
ROBERT MURRAY
2427 UNION ST.
BLUE ISLAND, IL 60406
(708) 972 9336

FULLERTON
ENGINEERING & DESIGN

1100 E. WOODFIELD ROAD, SUITE 500
SCHLAUBURG, ILLINOIS 60173
TEL: 815-988-8800
FAX: 815-988-8800
DESIGN: fullertoneng.com
www.fullertoneng.com

REV	DATE	DESCRIPTION

THESE DRAWINGS WERE PREPARED BY THE ENGINEER AND CONTROLLED BY THE ENGINEER. THE ENGINEER IS NOT RESPONSIBLE FOR THE ACCURACY OF THE INFORMATION AND BELIEF COMPATIBLE WITH THE REQUIREMENTS OF ALL APPLICABLE CODES.

PRELIMINARY NOT FOR CONSTRUCTION

ATT PROJECT NUMBER

A022PBP

PSA

4101PA

WIRE CENTER

HINSDALE

JURISDICTION

HINSDALE, IL

SHEET NUMBER

1 OF 7

GENERAL CONSTRUCTION NOTES:

ALL TRENCHED AREA SHALL BE COMPACTED AND RESTORED IN LIFTS. SODDED AREAS WILL BE RESTORED TO EXISTING CONDITIONS OR BETTER OR AS DIRECTED BY THE CITY ENGINEER. EROSION PROTECTION WILL BE REQUIRED DURING APPLICABLE OFF SEASON.

WHEN POSSIBLE, SAW CUTS SHALL BE MADE AT EXISTING JOINT LINES. ALL CONCRETE SHALL BE KEVED INTO EXISTING STRUCTURES. IF MINIMUM DISTANCE FROM JOINT TO SAW CUT LINE CANNOT BE OBTAINED, REMOVE AND REPLACE TO JOINT. ALL BASE OR SUB-BASE SHALL BE COMPACTED PER THE STANDARD SPECIFICATIONS FOR PUBLIC WORKS CONSTRUCTION.


THE FULL PERIMETER OF ANY ASPHALT RESTORATION LIMITS SHALL BE SEALED COMPLETELY AT THE EDGES OF THE CUT WITH LIQUID ASPHALTIC CEMENT IRONED IN WITH A HEATED SMOOTHING IRON OR BY MEANS OF INFRARED TREATMENT TO PREVENT WATER SEEPAGE INTO THE PAVEMENT, UNLESS OTHERWISE DIRECTED BY THE CITY ENGINEER.

ALL PAVEMENT PATCH OPENINGS THAT ARE OPEN TO TRAFFIC SHALL BE IMMEDIATELY SURFACED WITH A TEMPORARY BITUMINOUS PATCH AT LEAST THREE INCHES IN THICKNESS. THIS PATCH THEN MUST BE INSPECTED DAILY AND ADDITIONAL BITUMINOUS PATCH MATERIAL MUST BE PLACED DAILY IF NECESSARY, TO MAINTAIN THE PATCHED AREA AT THE SAME ELEVATION AS THE ADJACENT UNDISTURBED PAVEMENT FOR A PERIOD OF NOT LESS THAN 30 DAYS. AFTER 30 DAYS, PERMANENT REPLACEMENT IN KIND SHALL BE MADE TO THE BASE COURSE AND PAVEMENT SURFACE.

WORK SUMMARY

1. BORE FROM POLE TO POLE AND PLACE (1) 4"PC.
2. BORE FROM HANDHOLE TO BORE PIT (1) 4"PC.
3. PLACE 2 BOREPITS.

LOCALITY MAP

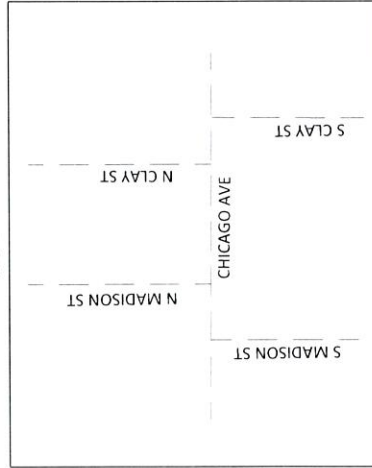

PRINT 3



24x36 SCALE 1" = 40'-0"
11x17 SCALE 1" = 80'-0"



AT&T ENGINEER CONTACT INFO
ROBERT MURRAY
2427 UNION ST.
BLUE ISLAND, IL 60406
(708) 972 9336

FULLERTON
ENGINEERING DESIGN

1180 E. WOODFIELD ROAD, SUITE 500
SCHLAUSBURG, ILLINOIS 60173
TEL 847-988-8400
DESIGN: 847-988-8400
www.fullertonengineering.com

REV	DATE	DESCRIPTION	BY

THE USER HEREBY CERTIFIES THAT THESE DRAWINGS WERE PREPARED BY THE ENGINEER OR UNDER HIS CLOSE PERSONAL SUPERVISION AND CONTROL, AND TO THE BEST OF HIS KNOWLEDGE AND BELIEF COMPLY WITH THE REQUIREMENTS OF ALL APPLICABLE CODES.

PRELIMINARY NOT FOR CONSTRUCTION

ATT PROJECT NUMBER	A022PBP
PSA	4101PA
WIRE CENTER	HINSDALE
JURISDICTION	HINSDALE, IL
SHEET NUMBER	2 OF 7

GENERAL CONSTRUCTION NOTES:

ALL TRENCHED AREA SHALL BE COMPACTED AND RESTORED IN LIFTS. SODDED AREAS WILL BE RESTORED TO EXISTING CONDITIONS OR BETTER OR AS DIRECTED BY THE CITY ENGINEER. EROSION PROTECTION WILL BE REQUIRED DURING APPLICABLE OFF SEASON.

WHEN POSSIBLE, SAW CUTS SHALL BE MADE AT EXISTING JOINT LINES. ALL CONCRETE SHALL BE KEYS INTO EXISTING STRUCTURES. IF MINIMUM DISTANCE FROM JOINT TO SAW CUT LINE CANNOT BE OBTAINED, REMOVE AND REPLACE TO JOINT. ALL BASE OR SUB-BASE SHALL BE COMPACTED PER THE STANDARD SPECIFICATIONS FOR PUBLIC WORKS CONSTRUCTION.


THE FULL PERIMETER OF ANY ASPHALT RESTORATION LIMITS SHALL BE SEALED COMPLETELY AT THE EDGES OF THE CUT WITH LIQUID ASPHALTIC CEMENT IRONED IN WITH A HEATED SMOOTHING IRON OR BY MEANS OF INFRARED TREATMENT TO PREVENT WATER SEEPAGE INTO THE PAVEMENT, UNLESS OTHERWISE DIRECTED BY THE CITY ENGINEER.

ALL PAVEMENT PATCH OPENINGS THAT ARE OPEN TO TRAFFIC SHALL BE IMMEDIATELY SURFACED WITH A TEMPORARY BITUMINOUS PATCH AT LEAST THREE INCHES IN THICKNESS. THIS PATCH THEN MUST BE INSPECTED DAILY AND ADDITIONAL BITUMINOUS PATCH MATERIAL MUST BE PLACED DAILY IF NECESSARY, TO MAINTAIN THE PATCHED AREA AT THE SAME ELEVATION AS THE ADJACENT UNDISTURBED PAVEMENT FOR A PERIOD OF NOT LESS THAN 30 DAYS AFTER 30 DAYS. PERMANENT REPLACEMENT IN KIND SHALL BE MADE TO THE BASE COURSE AND PAVEMENT SURFACE.


WORK SUMMARY

1. BORE FROM HANDHOLE TO BORE PIT AND PLACE (1) 4"PC.
2. PLACE 1 BOREPITS.

LOCALITY MAP

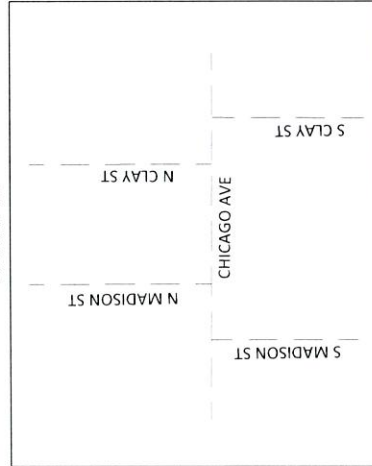

PRINT 2

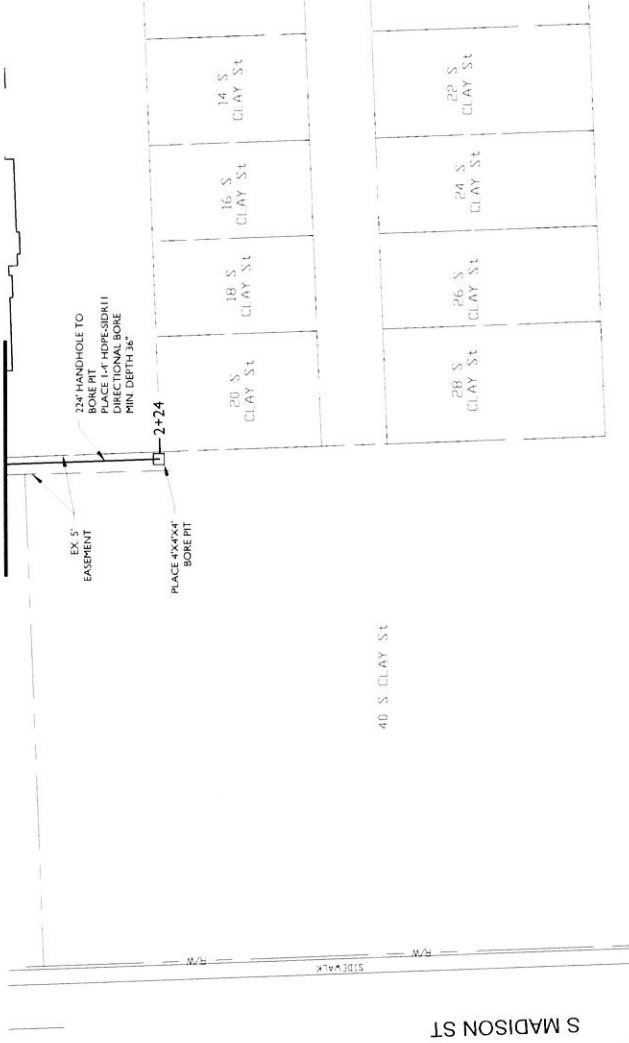

AT&T ENGINEER CONTACT INFO
ROBERT MURRAY
2427 UNION ST.
BLUE ISLAND, IL 60406
(708) 972 9336

FULLERTON
ENGINEERING DESIGN
1100 E WOODFIELD ROAD, SUITE 500
SCHLAUSBURG, ILLINOIS 60173
TEL 847-509-8400
DESIGN 1100 E WOODFIELD ROAD, SUITE 500
www.FullertonEngineering.com

REV	DATE	DESCRIPTION	BY

I HEREBY CERTIFY THAT THESE DRAWINGS WERE PREPARED BY ME OR UNDER MY CLOSE PERSONAL SUPERVISION AND TO THE BEST OF MY KNOWLEDGE AND BELIEF THEY COMPLY WITH THE REQUIREMENTS OF ALL APPLICABLE CODES.

PRELIMINARY - NOT FOR CONSTRUCTION

ATT PROJECT NUMBER	A022PBP
PSA	4101PA
WIRE CENTER	HINSDALE
JURISDICTION	HINSDALE, IL
SHEET NUMBER	3 OF 7



Know what's below.
Call before you dig.



24x36 SCALE 1" = 40'-0"
11x17 SCALE 1" = 80'-0"

GENERAL CONSTRUCTION NOTES:

ALL TRENCHED AREA SHALL BE COMPACTED AND RESTORED IN LIFTS. SODDED AREAS WILL BE RESTORED TO EXISTING CONDITIONS OR BETTER OR AS DIRECTED BY THE CITY ENGINEER. EROSION PROTECTION WILL BE REQUIRED DURING APPLICABLE OFF SEASON.

WHEN POSSIBLE, SAW CUTS SHALL BE MADE AT EXISTING JOINT LINES. ALL CONCRETE SHALL BE KEED INTO EXISTING STRUCTURES. IF MINIMUM DISTANCE FROM JOINT TO SAW CUT LINE CANNOT BE OBTAINED, REMOVE AND REPLACE TO JOINT. ALL BASE OR SUB-BASE SHALL BE COMPACTED PER THE STANDARD SPECIFICATIONS FOR PUBLIC WORKS CONSTRUCTION.



THE FULL PERIMETER OF ANY ASPHALT RESTORATION LIMITS SHALL BE SEALED COMPLETELY AT THE EDGES OF THE CUT WITH LIQUID ASPHALTIC CEMENT IRONED IN WITH A HEATED SMOOTHING IRON OR BY MEANS OF INFRARED TREATMENT TO PREVENT WATER SEEPAGE INTO THE PAVEMENT, UNLESS OTHERWISE DIRECTED BY THE CITY ENGINEER.

ALL PAVEMENT PATCH OPENINGS THAT ARE OPEN TO TRAFFIC SHALL BE IMMEDIATELY SURFACED WITH A TEMPORARY BITUMINOUS PATCH AT LEAST THREE INCHES IN THICKNESS. THIS PATCH THEN MUST BE INSPECTED DAILY AND ADDITIONAL BITUMINOUS PATCH MATERIAL MUST BE PLACED DAILY IF NECESSARY, TO MAINTAIN THE PATCHED AREA AT THE SAME ELEVATION AS THE ADJACENT UNDISTURBED PAVEMENT FOR A PERIOD OF NOT LESS THAN 30 DAYS. AFTER 30 DAYS, PERMANENT REPLACEMENT IN KIND SHALL BE MADE TO THE BASE COURSE AND PAVEMENT SURFACE.

WORK SUMMARY

1. BORE FROM POLE TO POLE AND PLACE (1) 4"PC.
2. PLACE 1 BOREPITS.

LOCALITY MAP

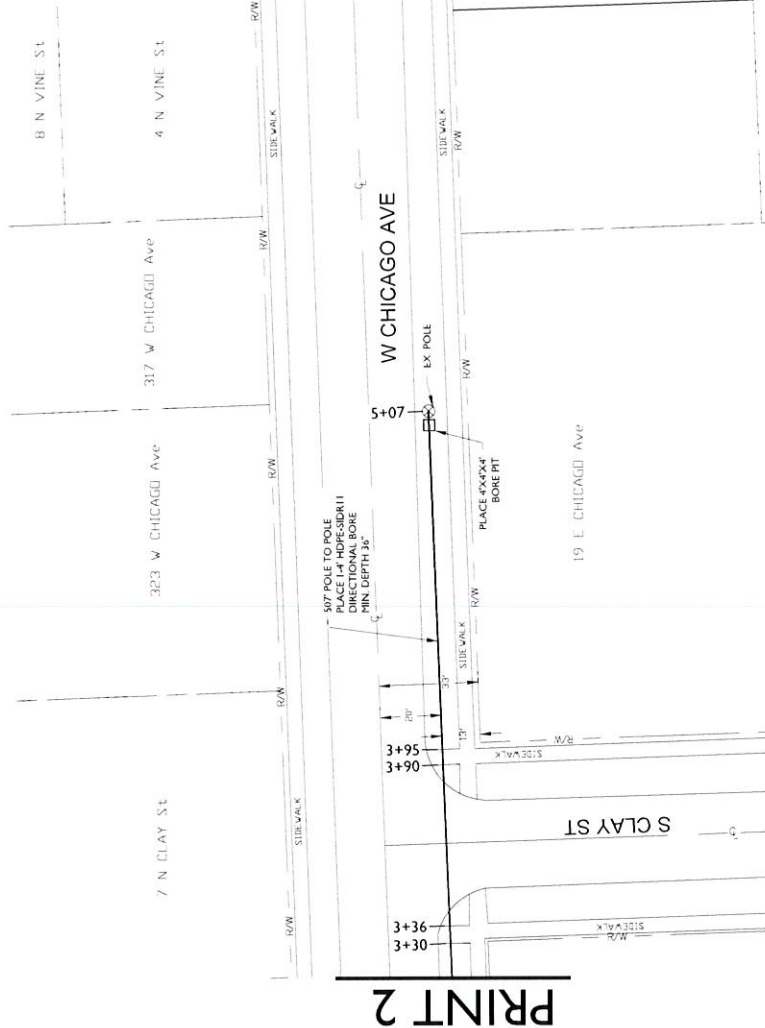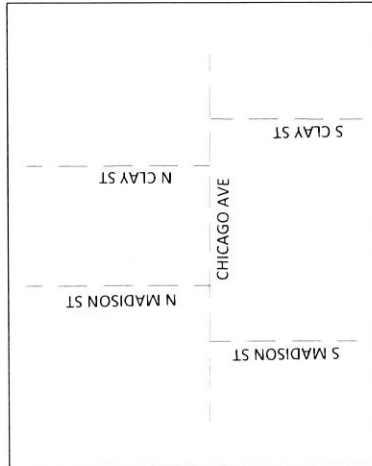

PRINT 2



24x36 SCALE 1" = 40'-0"
11x17 SCALE 1" = 80'-0"



AT&T ENGINEER CONTACT INFO
ROBERT MURRAY
2427 UNION ST.
BLUE ISLAND, IL 60406
(708) 972 9336

FULLERTON
ENGINEERING & DESIGN

1100 E. WOODFIELD ROAD, SUITE 500
SCHLAUBURG, ILLINOIS 60173
TEL: (708) 998-8800
DESIGN FAX: (708) 998-0200
www.FullertonEngineering.com

REV	DATE	DESCRIPTION	BY

I HEREBY CERTIFY THAT THESE DRAWINGS WERE PREPARED BY ME OR UNDER MY CLOSE PERSONAL SUPERVISION AND CONTROL, AND TO THE BEST OF MY KNOWLEDGE AND BELIEF THEY COMPLY WITH ALL CITY, STATE AND FEDERAL REQUIREMENTS OF ALL APPLICABLE CODES.

PRELIMINARY NOT FOR CONSTRUCTION

ATT PROJECT NUMBER

A022PBP

PSA

4101PA

WIRE CENTER

HINSDALE

JURISDICTION

HINSDALE, IL

SHEET NUMBER

4 OF 7

GENERAL CONSTRUCTION NOTES:

ALL TRENCHED AREA SHALL BE COMPACTED AND RESTORED IN LIFTS. SODDED AREAS WILL BE RESTORED TO EXISTING CONDITIONS OR BETTER OR AS DIRECTED BY THE CITY ENGINEER. EROSION PROTECTION WILL BE REQUIRED DURING APPLICABLE OFF SEASON.

WHEN POSSIBLE, SAW CUTS SHALL BE MADE AT EXISTING JOINT LINES. ALL CONCRETE SHALL BE KEYED INTO EXISTING STRUCTURES. IF MINIMUM DISTANCE FROM JOINT TO SAW CUT LINE CANNOT BE OBTAINED, REMOVE AND REPLACE TO JOINT. ALL BASE OR SUB-BASE SHALL BE COMPACTED PER THE STANDARD SPECIFICATIONS FOR PUBLIC WORKS CONSTRUCTION.



THE FULL PERIMETER OF ANY ASPHALT RESTORATION LIMITS SHALL BE SEALED COMPLETELY AT THE EDGES OF THE CUT WITH LIQUID ASPHALTIC CEMENT IRONED IN WITH A HEATED SMOOTHING IRON OR BY MEANS OF INFRARED TREATMENT TO PREVENT WATER SEEPAGE INTO THE PAVEMENT, UNLESS OTHERWISE DIRECTED BY THE CITY ENGINEER.

ALL PAVEMENT PATCH OPENINGS THAT ARE OPEN TO TRAFFIC SHALL BE IMMEDIATELY SURFACED WITH A TEMPORARY BITUMINOUS PATCH AT LEAST THREE INCHES IN THICKNESS. THIS PATCH THEN MUST BE INSPECTED DAILY AND ADDITIONAL BITUMINOUS PATCH MATERIAL MUST BE PLACED DAILY IF NECESSARY, TO MAINTAIN THE PATCHED AREA AT THE SAME ELEVATION AS THE ADJACENT UNDISTURBED PAVEMENT FOR A PERIOD OF NOT LESS THAN 30 DAYS. AFTER 30 DAYS, PERMANENT REPLACEMENT IN KIND SHALL BE MADE TO THE BASE COURSE AND PAVEMENT SURFACE.

WORK SUMMARY

1. BORE FROM POLE TO POLE AND PLACE (1) 4"PC.
2. PLACE 3 BOREPITS.

LOCALITY MAP

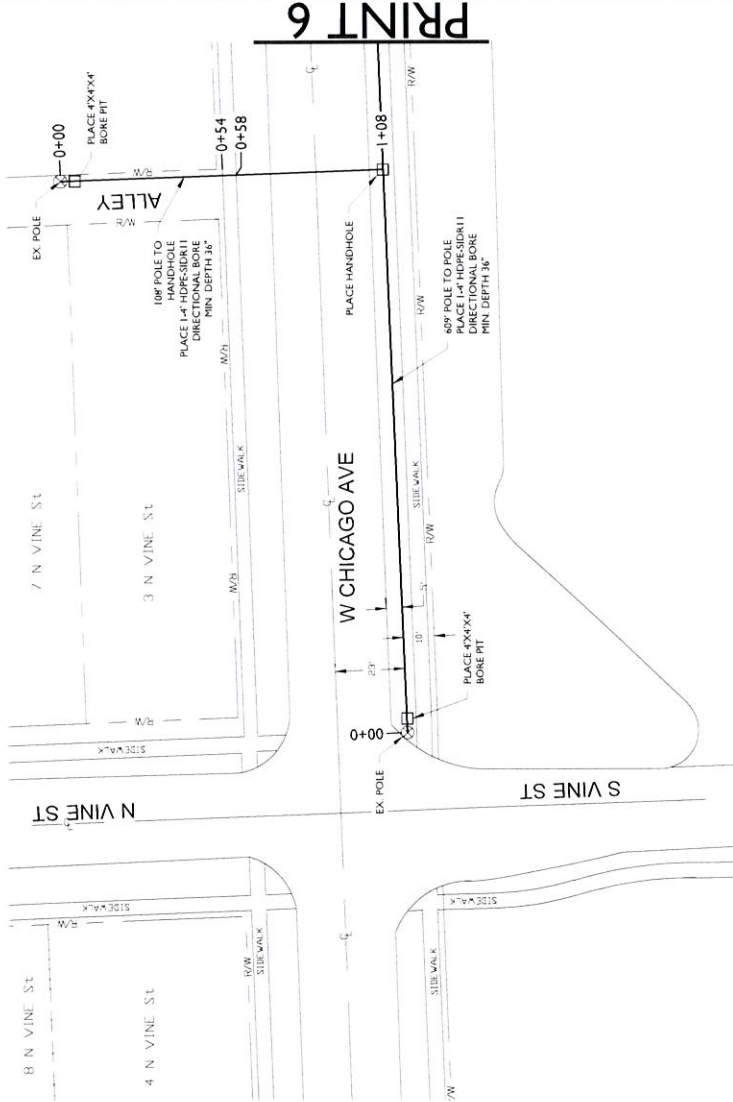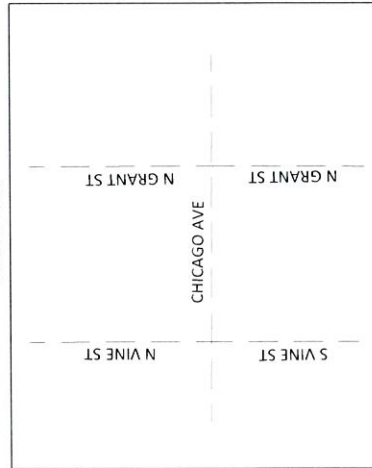

PRINT 6



AT&T ENGINEER CONTACT INFO
ROBERT MURRAY
2427 UNION ST.
BLUE ISLAND, IL 60406
(708) 972 9336

FULLERTON
ENGINEERING DESIGN

1100 E WOODFIELD ROAD, SUITE 500
SCHUMBERG, ILLINOIS 60173
TEL: 847-508-8400
FAX: 847-508-8401
DESIGN: 847-508-8402
www.FullertonEngineering.com

REV	DATE	DESCRIPTION

FOR MORE CLARITY THAN THESE DRAWINGS WHEN PREPARED BY THE CITY ENGINEER, THE CITY ENGINEER SHALL BE RESPONSIBLE FOR THE DESIGN AND CONSTRUCTION OF THE PROJECT, AND TO THE BEST OF HIS KNOWLEDGE AND BELIEF COMPLY WITH THE REQUIREMENTS OF ALL APPLICABLE CODES.

PRELIMINARY NOT FOR CONSTRUCTION

ATT PROJECT NUMBER

A022PBP

PSA

4101PA

WIRE CENTER

HINSDALE

JURISDICTION

HINSDALE, IL

SHEET NUMBER

5 OF 7



Know what's below.
Call before you dig.



24x36 SCALE: 1" = 40'-0"
11x17 SCALE: 1" = 80'-0"

GENERAL CONSTRUCTION NOTES:

ALL TRENCHED AREA SHALL BE COMPACTED AND RESTORED IN LIFTS. SODDED AREAS WILL BE RESTORED TO EXISTING CONDITIONS OR BETTER OR AS DIRECTED BY THE CITY ENGINEER. EROSION PROTECTION WILL BE REQUIRED DURING APPLICABLE OFF SEASON.

WHEN POSSIBLE, SAW CUTS SHALL BE MADE AT EXISTING JOINT LINES. ALL CONCRETE SHALL BE KEYED INTO EXISTING STRUCTURES. IF MINIMUM DISTANCE FROM JOINT TO SAW CUT LINE CANNOT BE OBTAINED, REMOVE AND REPLACE TO JOINT. ALL BASE OR SUB-BASE SHALL BE COMPACTED PER THE STANDARD SPECIFICATIONS FOR PUBLIC WORKS CONSTRUCTION.



THE FULL PERIMETER OF ANY ASPHALT RESTORATION LIMITS SHALL BE SEALED COMPLETELY AT THE EDGES OF THE CUT WITH LIQUID ASPHALTIC CEMENT IRONED IN WITH A HEATED SMOOTHING IRON OR BY MEANS OF INFRARED TREATMENT TO PREVENT WATER SEEPAGE INTO THE PAVEMENT, UNLESS OTHERWISE DIRECTED BY THE CITY ENGINEER.

ALL PAVEMENT PATCH OPENINGS THAT ARE OPEN TO TRAFFIC SHALL BE IMMEDIATELY SURFACED WITH A TEMPORARY BITUMINOUS PATCH AT LEAST THREE INCHES IN THICKNESS. THIS PATCH THEN MUST BE INSPECTED DAILY AND ADDITIONAL BITUMINOUS PATCH MATERIAL MUST BE PLACED, DAILY IF NECESSARY, TO MAINTAIN THE PATCHED AREA AT THE SAME ELEVATION AS THE ADJACENT UNDISTURBED PAVEMENT FOR A PERIOD OF NOT LESS THAN 30 DAYS. AFTER 30 DAYS, PERMANENT REPLACEMENT IN KIND SHALL BE MADE TO THE BASE COURSE AND PAVEMENT SURFACE.

WORK SUMMARY

1. BORE FROM POLE TO POLE AND PLACE (1) 4"PC.

LOCALITY MAP

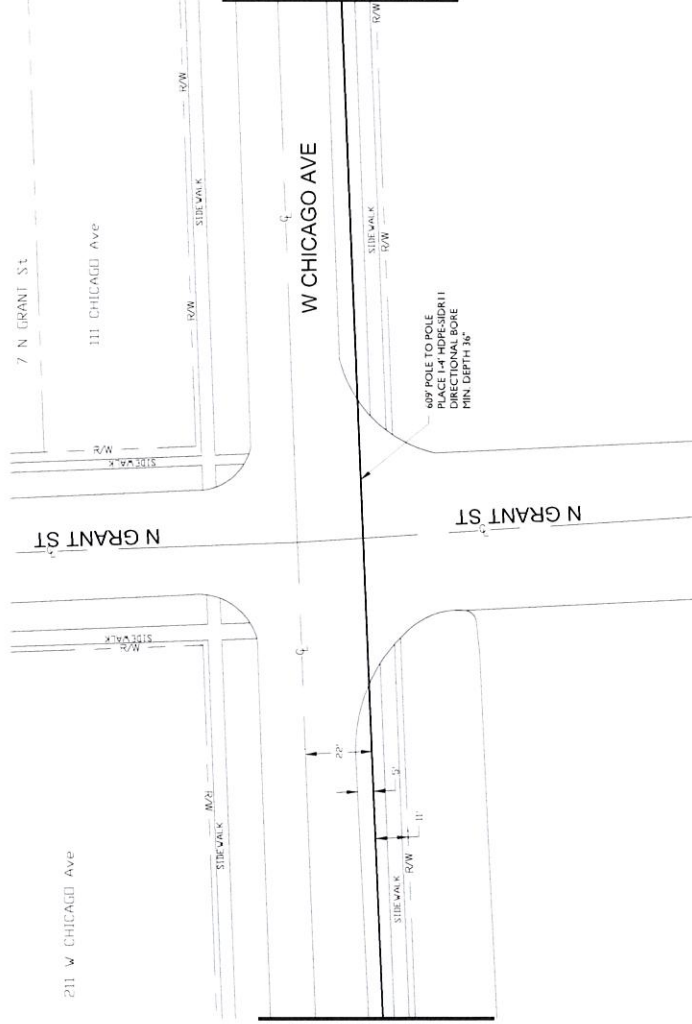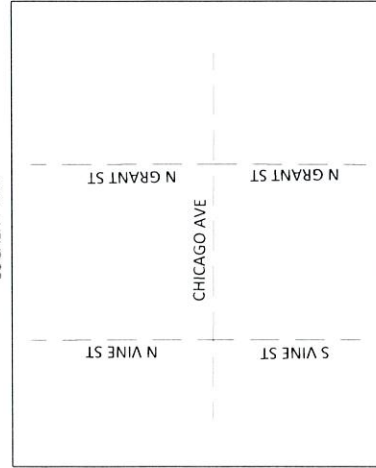

PRINT 5

PRINT 7



AT&T ENGINEER CONTACT INFO
ROBERT MURRAY
2427 UNION ST.
BLUE ISLAND, IL 60406
(708) 972 9336

FULLERTON
ENGINEERING DESIGN
1100 E WOODFIELD ROAD, SUITE 500
SCHLAUBURG, ILLINOIS 60173
TEL: 847-708-8600
DESIGN TEL: 847-708-8600
www.FullertonEngineering.com

REV	DATE	DESCRIPTION	BY

I HEREBY CERTIFY THAT THESE DRAWINGS WERE PREPARED BY ME OR UNDER MY CLOSE PERSONAL SUPERVISION AND TO THE BEST OF MY KNOWLEDGE AND BELIEF THEY COMPLY WITH ALL APPLICABLE CODES.

PRELIMINARY NOT FOR CONSTRUCTION

ATT PROJECT NUMBER

A022PBP

PSA

4101PA

WIRE CENTER

HINSDALE

JURISDICTION

HINSDALE, IL

SHEET NUMBER

6 OF 7



Know what's below.
Call before you dig.



24x36 SCALE 1" = 40'-0"
11x17 SCALE 1" = 80'-0"

GENERAL CONSTRUCTION NOTES:

ALL TRENCHED AREA SHALL BE COMPACTED AND RESTORED IN LIFTS. SODDED AREAS WILL BE RESTORED TO EXISTING CONDITIONS OR BETTER OR AS DIRECTED BY THE CITY ENGINEER. EROSION PROTECTION WILL BE REQUIRED DURING APPLICABLE OFF SEASON.

WHEN POSSIBLE, SAW CUTS SHALL BE MADE AT EXISTING JOINT LINES. ALL CONCRETE SHALL BE KEVED INTO EXISTING STRUCTURES, IF MINIMUM DISTANCE FROM JOINT TO SAW CUT LINE CANNOT BE OBTAINED, REMOVE AND REPLACE TO JOINT. ALL BASE OR SUB-BASE SHALL BE COMPACTED PER THE STANDARD SPECIFICATIONS FOR PUBLIC WORKS CONSTRUCTION.


THE FULL PERIMETER OF ANY ASPHALT RESTORATION LIMITS SHALL BE SEALED COMPLETELY AT THE EDGES OF THE CUT WITH LIQUID ASPHALTIC CEMENT IRONED IN WITH A HEATED SMOOTHING IRON OR BY MEANS OF INFRARED TREATMENT TO PREVENT WATER SEEPAGE INTO THE PAVEMENT, UNLESS OTHERWISE DIRECTED BY THE CITY ENGINEER.

ALL PAVEMENT PATCH OPENINGS THAT ARE OPEN TO TRAFFIC SHALL BE IMMEDIATELY SURFACED WITH A TEMPORARY BITUMINOUS PATCH AT LEAST THREE INCHES IN THICKNESS. THIS PATCH THEN MUST BE INSPECTED DAILY AND ADDITIONAL BITUMINOUS PATCH MATERIAL MUST BE PLACED, DAILY IF NECESSARY, TO MAINTAIN THE PATCHED AREA AT THE SAME ELEVATION AS THE ADJACENT UNDISTURBED PAVEMENT FOR A PERIOD OF NOT LESS THAN 30 DAYS. AFTER 30 DAYS, PERMANENT REPLACEMENT IN KIND SHALL BE MADE TO THE BASE COURSE AND PAVEMENT SURFACE.

WORK SUMMARY

1. BORE FROM POLE TO POLE AND PLACE (1) 4"PC.
2. PLACE 1 BORE PIT.

LOCALITY MAP

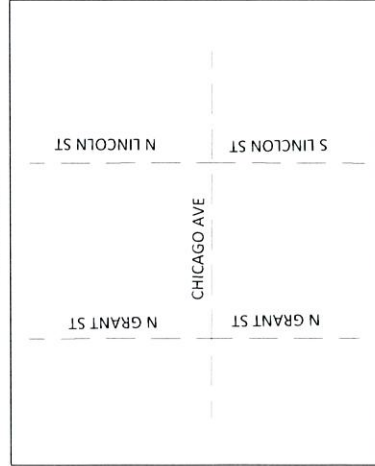

PRINT 6



24x36 SCALE 1" = 40'-0"
11x17 SCALE 1" = 80'-0"



AT&T ENGINEER CONTACT INFO:
ROBERT MURRAY
2427 UNION ST.
BLUE ISLAND, IL 60406
(708) 972 9336

FULLERTON
ENGINEERING DESIGN

1180 E. WOODFIELD ROAD, SUITE 500
SCHLAUSBURG, ILLINOIS 60173
DESIGN TEL: 847-908-8600
TEL: 847-908-8600
FAX: 847-908-8606
www.FullertonEngineering.com

NO.	DATE	DESCRIPTION	BY

THE ENGINEER CERTIFIES THAT THESE DRAWINGS WERE PREPARED BY HIMSELF OR UNDER HIS CLOSE PERSONAL SUPERVISION AND CONTROL, AND TO THE BEST OF HIS KNOWLEDGE AND BELIEF COMPLY WITH THE REQUIREMENTS OF ALL APPLICABLE CODES.

PRELIMINARY NOT FOR CONSTRUCTION

ATT PROJECT NUMBER	A022PBP
PSA	4101PA
WIRE CENTER	HINSDALE
JURISDICTION	HINSDALE, IL
SHEET NUMBER	7 OF 7